

MISSISSIPPI DEPARTMENT OF NATURAL RESOURCES

Bureau of Land and Water Resources

Southport Mall

P.O. Box 10631

Jackson, Mississippi 39209

WATER WELL DRILLERS LOG

F 2038
 Lincoln
 8-21-85

8-21 1985 date well completed
 Fitts well serv firm name
 Lincoln county well located

LANDOWNER:	description of formations encountered	from	to
Dennis Calvate			
R.H. Brockman, Inc. (mailing address)	Red Clay	0	20
	Red Sand	20	90
	Coarse Sand & gravel	90	105
WELL LOCATION:			
sec. 18 T 7 N R 6 E S W			
12 miles W of Broken (distance) (direction) (nearest town)			
WELL PURPOSE: Home (home, irrigation, municipal, industrial)			
WELL COMPLETION DATA:			
(1) diameter (inches) 4			
(2) total depth (feet) 105			
(3) static water level (feet) 85 below top of ground.			
(4) casing PVC, 95 (material) (depth)			
4 (size) If telescope see back.			
(5) screen 10, 95 (length) (depth to top)			
4, PVC (size) (material)			
(6) pump 1, 15 (HP) (yield gpm)			
Elmer (type power)			
(7) electric log No (yes or no)			
(organization running log)			
(8) how well bottom plugged Sanded			


RECEIVED
 SEP 13 1985

DRILLERS REMARKS:

Department of Natural Resources
 Bureau of Land & Water Resources

If well telescopes please sketch and show depths.

GROUND LEVEL

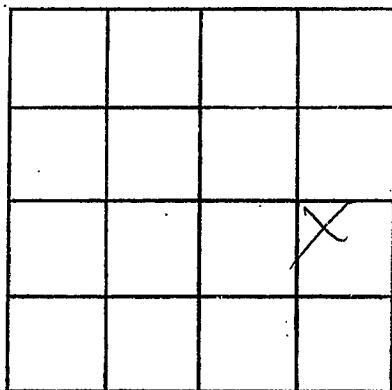

SECTION 18

Please indicate well location X.

ADDITIONAL INFORMATION

If more than one screen,
show locations of each on sketch.