

**MISSISSIPPI DEPARTMENT OF NATURAL RESOURCES**  
**Bureau of Land and Water Resources**  
 Southport Mall  
 P.O. Box 10631  
 Jackson, Mississippi 39209  
**WATER WELL DRILLERS LOG**

<u>Lincoln</u>
<u>F2039</u>

Jan. 1 1986 Gretn Water Well Lincoln  
 date well completed firm name county well located

LANDOWNER: <u>Roy Wallace</u>	description of formations encountered	from	to
<u>Route 4, Bogue Chitto, Ms.</u>			

(mailing address)

**WELL LOCATION:**  
 sec. 23 T 7 N R 6 E  
                   S                  W  
8 miles SW of Brookhaven  
 (distance) (direction) (nearest town)

**WELL PURPOSE:** home  
 (home, irrigation, municipal, industrial)

**WELL COMPLETION DATA:**

(1) diameter (inches) 4

(2) total depth (feet) 72

(3) static water level (feet) 40 below above top of ground.

(4) casing PVC 62  
 (material) (depth)  
4" if telescope see back.  
 (size)

(5) screen 10' 62'  
 (length) (depth to top)  
.010 PVC  
 (size) (material)

(6) pump 1/2 hp sub 10  
 (HP) (yield gpm)


electricity  
 (type power)

(7) electric log no  
 (yes or no)

(organization running log)

(8) how well bottom plugged back wash valve


**DRILLERS REMARKS:**

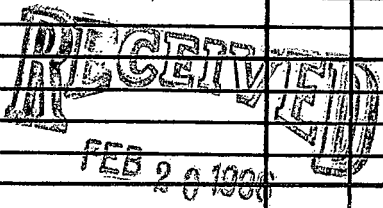

Department of Natural Resources  
 Bureau of Land & Water Resources

If well telescopes please sketch and show depths.

GROUND LEVEL

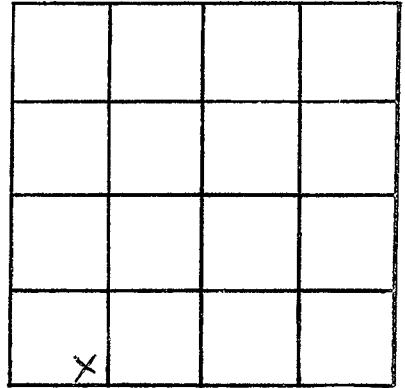

SECTION 23

Please indicate well location X.

ADDITIONAL INFORMATION

If more than one screen,  
show locations of each on sketch.