

MISSISSIPPI DEPARTMENT OF NATURAL RESOURCES

Bureau of Land and Water Resources

Southport Mall

P.O. Box 10631

Jackson, Mississippi 39209

WATER WELL DRILLERS LOG

LINCOLN
F
2042

May 16 19 86 Grenn Water Well Lincoln  
 date well completed firm name county well located

LANDOWNER: Bobby W. Beavers	description of formations encountered		from	to
Rt. 2	Citronelle		15	110
Brookhaven, Ms. (mailing address)				
<b>WELL LOCATION:</b>				
sec. <u>24</u> T <u>7</u> N R <u>6</u> E S W				
5 miles West of Brookhaven (distance) (direction) (nearest town)				
<b>WELL PURPOSE:</b> home (home, irrigation, municipal, industrial)				
<b>WELL COMPLETION DATA:</b>				
(1) diameter (inches) <u>4</u>				
(2) total depth (feet) <u>110</u>				
(3) static water level (feet) <u>50</u> below top of ground. above				
(4) casing <u>PVC</u> <u>100</u> (material) (depth)				
<u>4"</u> (size) If telescope see back.				
(5) screen <u>10'</u> <u>100'</u> (length) (depth to top)				
<u>.010</u> <u>PVC</u> (size) (material)				
(6) pump <u>did not install</u> ± (HP) (yield gpm)				
<u></u> (type power)				
(7) electric log <u>no</u> (yes or no)				
<u></u> (organization running log)				
(8) how well bottom plugged <u>back wash valve</u>				


RECEIVED  
 JUN 27 1986

Department of Natural Resources  
 Bureau of Land & Water Resources

DRILLERS REMARKS:

If well telescopes please sketch and show depths.

GROUND LEVEL

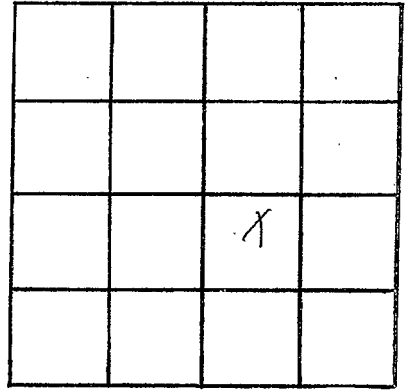

SECTION 24

Please indicate well location X.

ADDITIONAL INFORMATION

If more than one screen,  
show locations of each on sketch.