

MISSISSIPPI DEPARTMENT OF NATURAL RESOURCES
Bureau of Land and Water Resources
 Southport Mall
 P.O. Box 10631
 Jackson, Mississippi 39209
WATER WELL DRILLERS LOG

LINCOLN
F
2043

May 20 1986 Grenn Water Well Lincoln
 date well completed firm name county well located


LANDOWNER: Howard Case
 Route 2
 Brookhaven, Mis.
 (mailing address)

description of formations encountered	from	to
Citronelle	1	90

WELL LOCATION:
 sec. 24 T 7 N R 6 E
 S W
 5 miles West of Brookhaven
 (distance) (direction) (nearest town)

WELL PURPOSE: home
 (home, irrigation, municipal, industrial)

- WELL COMPLETION DATA:
- (1) diameter (inches) 4
 - (2) total depth (feet) 90
 - (3) static water level (feet) 68 below above top of ground.
 - (4) casing PVC 80' (material) (depth)
 4" (size) if telescope see back.
 - (5) screen 10' 80' (length) (depth to top)
 .010 PVC (size) (material)
 - (6) pump 1/2 sub 10 (HP) (yield gpm)
 electricity (type power)
 - (7) electric log no (yes or no)
 (organization running log)
 - (8) how well bottom plugged back wash valve

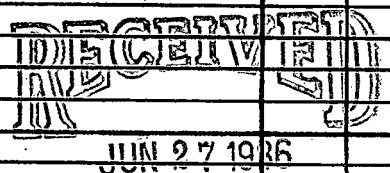

Department of Natural Resources
 Bureau of Land & Water Resources

DRILLERS REMARKS:

If well telescopes please sketch and show depths.

GROUND LEVEL

			X

SECTION 24

Please indicate well location X.

ADDITIONAL INFORMATION

If more than one screen,
show locations of each on sketch.