


LINCOLN  
F  
2044

MISSISSIPPI DEPARTMENT OF NATURAL RESOURCES  
Bureau of Land and Water Resources  
Southport Mall  
P.O. Box 10631  
Jackson, Mississippi 39209  
WATER WELL DRILLERS LOG

6-4-1986 Gretn Water Well Lincoln  
date well completed firm name county well located


LANDOWNER: Percy Wilson Rt. 2	description of formations encountered Citronelle	from 1	to 118
Brookhaven, Ms. (mailing address)			
WELL LOCATION: sec. 13 T 7 N R 6 E S W 4 miles W of Brookhaven (distance) (direction) (nearest town)			
WELL PURPOSE: home (home, irrigation, municipal, industrial)			
WELL COMPLETION DATA:			
(1) diameter (inches) 4			
(2) total depth (feet) 118			
(3) static water level (feet) 70 below top of ground.			
(4) casing PVC 108' (material) (depth) 4" if telescope see back. (size)			
(5) screen 10' 108' (length) (depth to top) .010 PVC (size) (material)			
(6) pump did not install (HP) (yield gpm) (type power)			
(7) electric log no (yes or no) (organization running log)			
(8) how well bottom plugged back wash valve			
DRILLERS REMARKS:			

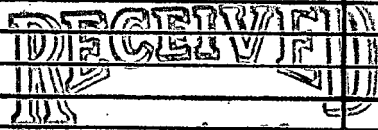

Department of Natural Resources  
Bureau of Land & Water Resources

If well telescopes please sketch and show depths.

GROUND LEVEL

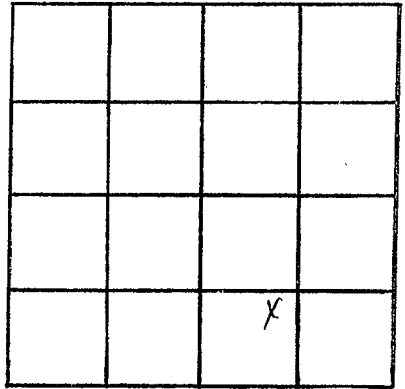

SECTION 13

Please indicate well location X.

ADDITIONAL INFORMATION

If more than one screen,  
show locations of each on sketch.