

MISSISSIPPI DEPARTMENT OF NATURAL RESOURCES  
Bureau of Land and Water Resources  
Southport Mall  
P.O. Box 10631  
Jackson, Mississippi 39209  
**WATER WELL DRILLERS LOG**

LINCOLN  
F  
2045

6-16 19 86 Grenn Water Well Lincoln  
date well completed firm name county well located


LANDOWNER:	description of formations encountered	from	to
Millard Smith Route 2, Box 451 Brookhaven, Ms. (mailing address)	Citronelle	1	78
<b>WELL LOCATION:</b>			
sec. <u>19</u> T. <u>7</u> N R. <u>6</u> E S W <u>3</u> miles SW of Brookhaven, (distance) (direction) (nearest town)			
<b>WELL PURPOSE:</b> <u>home</u> (home, irrigation, municipal, industrial)			
<b>WELL COMPLETION DATA:</b>			
(1) diameter (inches) <u>4</u>			
(2) total depth (feet) <u>78</u>			
(3) static water level (feet) <u>48</u> below top of ground. above			
(4) casing <u>PVC</u> , <u>68</u> (material) (depth) <u>4"</u> (size) if telescope see back.			
(5) screen <u>10'</u> , <u>68'</u> (length) (depth to top) <u>.010</u> <u>PVC</u> (size) (material)			
(6) pump <u>1/2 sub</u> <u>10</u> (HP) (yield gpm) <u>electricity</u> (type power)			
(7) electric log <u>no</u> (yes or no)  (organization running log)			
(8) how well bottom plugged <u>back wash valve</u>			
<b>DRILLERS REMARKS:</b>			

**RECEIVED**  
**DEPARTMENT OF NATURAL RESOURCES**  
**BUREAU OF LAND & WATER**  
JUL 21 1986

Department of Natural Resources  
Bureau of Land & Water Resources

If well telescopes please sketch and show depths.

GROUND LEVEL

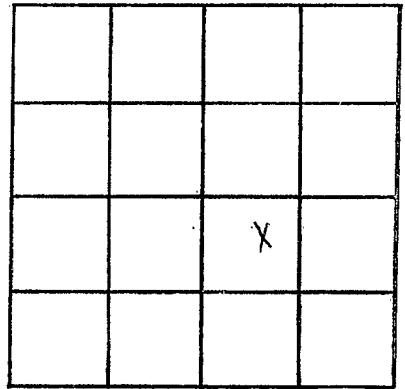

SECTION 19

Please indicate well location X.

ADDITIONAL INFORMATION

If more than one screen,  
show locations of each on sketch.