

LINCOLN  
F 2016

MISSISSIPPI DEPARTMENT OF NATURAL RESOURCES  
Bureau of Land and Water Resources  
Southport Mall  
P.O. Box 10631  
Jackson, Mississippi 39209  
WATER WELL DRILLERS LOG

10/26/86  
date well completed

1986 Eastley Plumbing Co  
firm name

@ Gunn Drilling  
Lincoln  
county well located

LANDOWNER: Maxieno Smith  
RT 7 Box 422  
Brookhaven, MS. 39601  
(mailing address)

description of formations encountered	from	to
Clay	0	10
Clay & Gravel	10	62
Clay	62	200
Sand	200	240

WELL LOCATION:  
sec. 5 T. 7 N R. 6 E  
10 miles W of Zetas  
(distance) (direction) (nearest town)

WELL PURPOSE: Home  
(home, irrigation, municipal, industrial)

WELL COMPLETION DATA:

(1) diameter (inches) 4"  
(2) total depth (feet) 240'  
(3) static water level (feet) 86' below top of ground.  
(4) casing PVC, 230' (depth)  
4" (size) if telescope see back.  
(5) screen 10' (length), 230' (depth to top)  
4" (size), PVC (material)  
(6) pump 1 (HP), 10 (yield gpm)  
electricity (type power)  
(7) electric log No (yes or no)  
(organization running log)  
(8) how well bottom plugged Barkwith Valve


DRILLERS REMARKS:

RECEIVED  
DEC 24 1986

Department of Natural Resources  
Bureau of Land & Water Resources

If well telescopes please sketch and show depths.

GROUND LEVEL

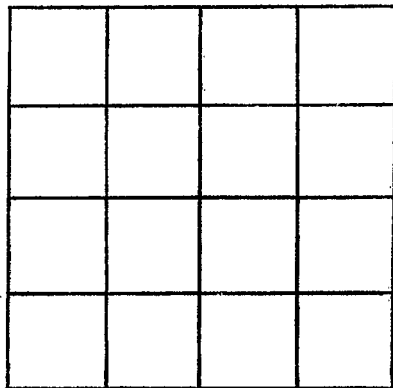

SECTION \_\_\_\_\_

Please indicate well location X.

ADDITIONAL INFORMATION

If more than one screen, show locations of each on sketch.