

# MISSISSIPPI DEPARTMENT OF NATURAL RESOURCES

Bureau of Land and Water Resources

P.O. Box 10631

Jackson, Mississippi 39209

## WATER WELL DRILLERS LOG

COUNTY WELL LOCATED <i>Lincoln</i>	
WELL NUMBER <b>F 2051</b>	CODED
DATE WELL COMPLETED <b>6-23-87</b>	

PERMIT NUMBER
NAME OF DRILLING FIRM <i>Green Water Well &amp; Pump</i>

NAME & MAILING ADDRESS OF LANDOWNER <i>Rivers Jones</i> <b>R 7 D</b>		
WELL LOCATION: SEC <u>8</u> TOWNSHIP <u>7</u> RANGE <u>6</u> <span style="font-size: small;">(N) (E) S W</span>		
DISTANCE <u>1.2</u> Miles	DIRECTION <u>W</u>	NEAREST TOWN <u>Brookhaven</u>
OTHER LANDMARK		
WELL PURPOSE: Home Irrigation, Municipal, Industrial, Fish Pond, etc. <i>home</i>		

<b>PUMP DATA</b>		
PUMP TYPE (Circle One): <input checked="" type="radio"/> Submersible    Turbine    Jet    Flowing Well, Other (Describe) _____		
POWER TYPE (Circle One): <input checked="" type="radio"/> Electric    Tractor, Diesel, Gasoline, Butane, Other (Describe) _____		
Pump Capacity (GPM) <b>10</b>	No. of Stages <b>10</b>	Setting Depth <b>90</b> FT.
PUMP TEST		
Well yielded <u>10</u> GPM with a drawdown of <u>5</u> ft. after <u>10</u> hours of pumping		

<b>WELL DATA</b>		
Well Depth <b>98</b>	Casing Diameter (In.) <b>4</b>	Casing Length (Ft.) <b>88</b>
Type of Casing <b>PVC</b>	Hole Depth <b>104</b>	Depth to Static Water Level <b>70</b>
TYPE OF COMPLETION: (Circle One or More): <input checked="" type="radio"/> Gravel Packed    Underreamed, Telescoped, Natural Development, Open Hole, Other		
Top of Lap Pipe or Reduction in Casing  FEET    IF TELESCOPED OR MORE THAN ONE SCREEN: USE BACK PAGE		

<b>LOG DATA</b>	
TYPE OF LOG RUN (Circle One): Electric, Gamma Ray, Density, Sonic, <input checked="" type="radio"/> No Log Run, Neutron, Other (Describe) _____	
Name of Organization Running Log	

<b>SCREEN DATA</b>		
Diameter - Inches <b>4</b>	Length - Feet <b>10</b>	Slot Size - Inches <b>10/10</b>
Screen Type <b>PVC</b>	Depth to Bottom - Feet <b>98</b>	


<b>GEOLOGIC DATA (Office Use Only)</b>			
Surface Elev.	Geologic Unit	Unit Thickness	Depth to Top
Subs. SWL	Date	Analysis	Aquifer Test
Driller's Remarks			

DESCRIPTION OF FORMATIONS ENCOUNTERED	FROM	TO	FORMATION (Continued)
<i>Citronelle</i>	<b>1</b>	<b>98</b>	<b>RECEIVED</b>  <b>AUG 14 1987</b>  Department of Natural Resources Bureau of Land & Water Resources
<i>Clay</i>	<b>98</b>	<b>104</b>	

IF MORE SPACE IS NEEDED, USE BACK

If well telescopes please sketch and show depths.

GROUND LEVEL

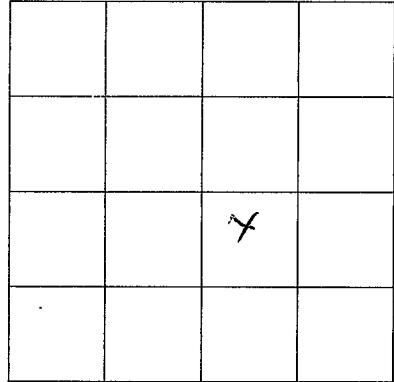

SECTION 8

Please indicate well location X.

ADDITIONAL INFORMATION

If more than one screen,  
show location of each on sketch.