

MISSISSIPPI DEPARTMENT OF NATURAL RESOURCES

Bureau of Land and Water Resources

P.O. Box 10631

Jackson, Mississippi 39209

WATER WELL DRILLERS LOG

COUNTY WELL LOCATED
Lincoln

WELL NUMBER F 2057 CODED

DATE WELL COMPLETED
7-7-88

PERMIT NUMBER

NAME OF DRILLING FIRM
Greenwater Well & Supply, Inc.

NAME & MAILING ADDRESS OF LANDOWNER
Jesse Warren
Rt 2 Box 615
Brookhaven, Miss.

WELL LOCATION: SEC 18 TOWNSHIP 7 RANGE 5
N S W E

DISTANCE 8 Miles West of Brookhaven

OTHER LANDMARK

WELL PURPOSE: Home Irrigation, Municipal, Industrial, Fish Pond, etc.

PUMP DATA

PUMP TYPE (Circle One):
Submersible, Turbine, Jet, Flowing Well,
Other (Describe) Did Not Install

POWER TYPE (Circle One):
Electric, Tractor, Diesel, Gasoline, Butane,
Other (Describe) H/P

Pump Capacity (GPM) No. of Stages Setting Depth FT.

PUMP TEST

Well yielded 20 GPM with
a drawdown of 0 ft.
after 2 hours of pumping

WELL DATA

Well Depth 162 Casing Diameter (In.) 4 Casing Length (Ft.) 142

Type of Casing PVC Hole Depth 175 Depth to Static Water Level 77

TYPE OF COMPLETION: (Circle One or More):
Gravel Packed, Underreamed, Telescoped,
Natural Development, Open Hole, Other

Top of Lap Pipe or Reduction in Casing

FEET IF TELESCOPED OR MORE THAN ONE SCREEN: USE BACK PAGE

LOG DATA

TYPE OF LOG RUN (Circle One):
Electric, Gamma Ray, Density, Sonic, Neutron,
Other (Describe) No Log Run

Name of Organization Running Log

SCREEN DATA

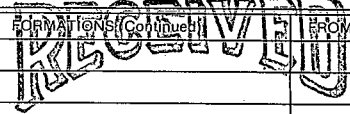
Diameter - Inches 4 Length - Feet 20 Slot Size - Inches .010

Screen Type PVC Depth to Bottom - Feet 162

GEOLOGIC DATA (Office Use Only)

Surface Elev.	Geologic Unit	Unit Thickness	Depth to Top
Subs. SWL	Date	Analysis	Aquifer Test

Driller's Remarks

DESCRIPTION OF FORMATIONS ENCOUNTERED	FROM	TO	FORMATIONS (Continued)	FROM	TO
<u>Citronelle</u>	<u>0</u>	<u>80</u>	 <u>SEP 19 1988</u> Department of Natural Resources Bureau of Land & Water Resources		
<u>Clay</u>	<u>80</u>	<u>120</u>			
<u>Sand</u>	<u>120</u>	<u>165</u>			
<u>Clay</u>	<u>165</u>	<u>175</u>			

IF MORE SPACE IS NEEDED, USE BACK

If well telescopes please
sketch and show depths.

GROUND LEVEL

X			

SECTION 18

Please indicate well location X.

ADDITIONAL INFORMATION

If more than one screen,
show location of each on sketch.