

MISSISSIPPI DEPARTMENT OF NATURAL RESOURCES
Bureau of Land and Water Resources

P.O. Box 10631

Jackson, Mississippi 39209

WATER WELL DRILLERS LOG

COUNTY WELL LOCATED <i>Lincoln</i>	
WELL NUMBER F 2060	CODED
DATE WELL COMPLETED <i>9/8/88</i>	

PERMIT NUMBER
NAME OF DRILLING FIRM <i>Bradley's Water Well</i>
<i>Brookhaven, MS 39619</i>

NAME & MAILING ADDRESS OF LANDOWNER <i>Mark Smith</i>			
<i>Brookhaven, MS</i>			
<i>Lincoln 39601</i>			
WELL LOCATION:	SEC	TOWNSHIP	RANGE
<i>Lincoln 5</i>		<i>7 N 6 E</i>	<i>W</i>
DISTANCE	DIRECTION	NEAREST TOWN	
<i>6</i> Miles	<i>NW</i>	<i>Brookhaven</i>	
OTHER LANDMARK <i>2 miles from Loyd Stary School</i>			
WELL PURPOSE: Home, Irrigation, Municipal, Industrial, Fish Pond, etc. <i>Home</i>			

PUMP DATA		
PUMP TYPE (Circle One): <u>Submersible</u> Turbine, Jet, Flowing Well, Other (Describe) _____		
POWER TYPE (Circle One): <u>Electric</u> Tractor, Diesel, Gasoline, Butane, Other (Describe) _____		
Pump Capacity (GPM) <i>10</i>	No. of Stages <i>9</i>	Setting Depth <i>70</i> FT.
PUMP TEST		
Well yielded _____ GPM with a drawdown of _____ ft. after _____ hours of pumping		

WELL DATA		
Well Depth <i>100ft.</i>	Casing Diameter (In.) <i>4in.</i>	Casing Length (Ft.) <i>80ft.</i>
Type of Casing <i>PVC#40</i>	Hole Depth <i>100ft.</i>	Depth to Static Water Level
TYPE OF COMPLETION: (Circle One or More): <u>Natural Development</u> Gravel Packed, Underreamed, Telescoped, Open Hole, Other		
Top of Lap Pipe or Reduction in Casing		
FEET	IF TELESCOPED OR MORE THAN ONE SCREEN: USE BACK PAGE	

LOG DATA	
TYPE OF LOG RUN (Circle One): <u>No Log Run</u> Electric, Gamma Ray, Density, Sonic, Neutron, Other (Describe) _____	
Name of Organization Running Log	

SCREEN DATA		
Diameter - Inches <i>4in.</i>	Length - Feet <i>20ft.</i>	Slot Size - Inches <i>0.10</i>
Screen Type <i>PVC</i>	Depth to Bottom - Feet <i>100ft.</i>	

GEOLOGIC DATA (Office Use Only)			
Surface Elev.	Geologic Unit	Unit Thickness	Depth to Top
Subs. SWL	Date	Analysis	Aquifer Test

Driller's Remarks

RECEIVED
APR 16 1990


DESCRIPTION OF FORMATIONS ENCOUNTERED	FROM	TO	FORMATIONS (Continued)	
			FROM	TO
<i>clay</i>	<i>0</i>	<i>20ft.</i>		
<i>sand</i>	<i>20ft.</i>	<i>30ft.</i>		
<i>hard & gravel</i>	<i>30ft.</i>	<i>50ft.</i>		
<i>fine sand</i>	<i>50ft.</i>	<i>80ft.</i>		
<i>rocky sand</i>	<i>80ft.</i>	<i>100ft.</i>		

Department of Natural Resources
Bureau of Land & Water Resources

IF MORE SPACE IS NEEDED, USE BACK

If well telescopes please
sketch and show depths.

GROUND LEVEL

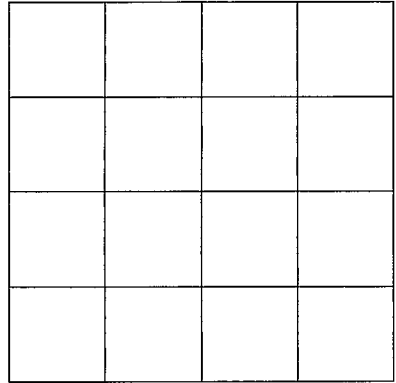

SECTION _____

Please indicate well location X.

ADDITIONAL INFORMATION

If more than one screen,
show location of each on sketch.