

**MISSISSIPPI DEPARTMENT OF ENVIRONMENTAL QUALITY**

Office of Land and Water Resources

P. O. Box 10631  
Jackson, MS 39289-0631  
**WATER WELL DRILLERS LOG**

COUNTY WELL LOCATED <b>LINCOLN</b>	
WELL NUMBER <b>F 2075</b>	CODED
DATE WELL COMPLETED <b>1-22-94</b>	

PERMIT NUMBER
NAME OF DRILLING FIRM <b>FITZGERALD Well Serv</b>

NAME & MAILING ADDRESS OF LANDOWNER <b>Mickey Myers P.O. Boxue Hill, MS</b>		
WELL LOCATION: SEC	TOWNSHIP	RANGE
<b>14</b>	<b>7</b>	<b>6</b>
	<b>N</b>	<b>E</b>
	<b>S</b>	<b>W</b>
DISTANCE	DIRECTION	NEAREST TOWN
<b>3 1/2</b> Miles	<b>W</b>	<b>Boxue Hill</b>
OTHER LANDMARK		
WELL PURPOSE: Home, Irrigation, Municipal, Industrial, Fish Pond, etc. <b>Home</b>		

PUMP DATA		
PUMP TYPE (Circle One): <input checked="" type="checkbox"/> Submersible, Turbine, Jet, Flowing Well, Other (Describe)		
POWER TYPE (Circle One): <input checked="" type="checkbox"/> Electric, Tractor, Diesel, Gasoline, Butane, Other (Describe) <b>H/P 1/2</b>		
Pump Capacity (GPM)	No. of Stages	Setting Depth
<b>10</b>	<b>8</b>	<b>90</b> FT.
PUMP TEST		
Well yielded <b>25</b> GPM with a drawdown of <b>2</b> ft. after <b>2</b> hours of pumping		

WELL DATA		
Well Depth <b>105</b>	Casing Diameter (In.) <b>4</b>	Casing Length (Ft.) <b>95</b>
Type of Casing <b>PVC</b>	Hole Depth <b>105</b>	Depth to Static Water Level <b>62</b>

LOG DATA	
TYPE OF LOG RUN (Circle One): Electric, Gamma Ray, Density, Sonic, Neutron, Other (Describe) <b>No Log Run</b>	
Name of Organization Running Log	

TYPE OF COMPLETION: (Circle One or More): <input checked="" type="checkbox"/> Gravel Packed, Underreamed, Telescoped, Natural Development, Open Hole, Other			
--	--	--	--

GEOLOGIC DATA (Office Use Only)			
Surface Elev.	Geologic Unit	Unit Thickness	Depth to Top
Subs. SWL	Date	Analysis	Aquifer Test

WELL GROUTED TO A DEPTH OF <b>10 FEET</b>
Type Grout (circle one): Cement, Bentonite, <b>or Mix</b>

Driller's Remarks


SCREEN DATA		
Diameter - Inches <b>4</b>	Length - Feet <b>10</b>	Slot Size - Inches <b>10/10</b>
Screen Type <b>PVC</b>	Depth to Bottom - Feet <b>105</b>	

DESCRIPTION OF FORMATIONS ENCOUNTERED	FROM	TO	FORMATIONS (Continued)	FROM	TO
<b>Red Clay</b>	<b>0</b>	<b>20</b>	<b>RECEIVED</b> <b>FEB 11 1994</b> Dept. of Environmental Quality Office of Land & Water Resources		
<b>Red Sand</b>	<b>20</b>	<b>90</b>			
<b>Coarse Sand</b>	<b>90</b>	<b>105</b>			

IF MORE SPACE IS NEEDED, USE BACK

If well telescopes please sketch and show depths.

GROUND LEVEL

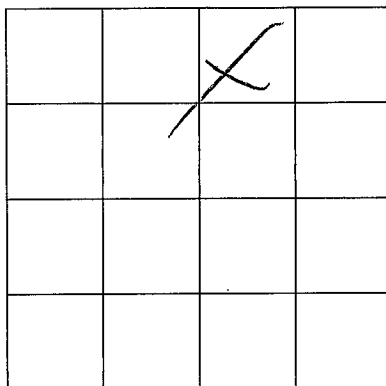

SECTION 14  
Please indicate well location X.

ADDITIONAL INFORMATION

If more than one screen,  
show location of each on sketch.