

**MISSISSIPPI DEPARTMENT OF ENVIRONMENTAL
QUALITY**

Office of Land and Water Resources

P. O. Box 10631
Jackson, MS 39289-0631
WATER WELL DRILLERS LOG

COUNTY WELL LOCATED <u>Lincoln.</u>	
WELL NUMBER <u>F 2108</u>	CODED
DATE WELL COMPLETED <u>12-15-98</u>	

PERMIT NUMBER
NAME OF DRILLING FIRM <u>Fitzgerald Well.</u>

NAME & MAILING ADDRESS OF LANDOWNER <u>Douglas Calcuter</u> <u>Posey Rd.</u>			
WELL LOCATION: SEC <u>29</u> TOWNSHIP <u>7</u> RANGE <u>6</u> <u>S</u> <u>W</u>			
DISTANCE <u>10</u> Miles	DIRECTION <u>West</u>	NEAREST TOWN <u>Brookhaven.</u>	
OTHER LANDMARK			
WELL PURPOSE <input checked="" type="radio"/> Home Irrigation, Municipal, Industrial, Fish Pond, etc.			

PUMP DATA		
PUMP TYPE (Circle One): Submersible, Turbine, Jet, Flowing Well, Other (Describe) _____		
POWER TYPE (Circle One): Electric, Tractor, Diesel, Gasoline, Butane, Other (Describe) _____ H/P _____		
Pump Capacity (GPM)	No. of Stages	Setting Depth FT.
PUMP TEST Well yielded _____ GPM with a drawdown of _____ ft. after _____ hours of pumping		

WELL DATA		
Well Depth <u>170</u>	Casing Diameter (In.) <u>4"</u>	Casing Length (Ft.) <u>150'</u>
Type of Casing <u>PVC</u>	Hole Depth <u>170'</u>	Depth to Static Water Level <u>32'</u>
TYPE OF COMPLETION: (Circle One or More): <input checked="" type="radio"/> Gravel Packed, <input type="radio"/> Underreamed, <input type="radio"/> Telescoped, <input type="radio"/> Natural Development, <input type="radio"/> Open Hole, <input type="radio"/> Other (Describe) _____		
WELL GROUTED TO A DEPTH OF <u>10</u> FEET Type Grout (circle one): Cement, Bentonite, or Mix		

LOG DATA	
TYPE OF LOG RUN (Circle One): No Log Run, Electric, Gamma Ray, Density, Sonic, Neutron, Other (Describe) _____	
Name of Organization Running Log	

SCREEN DATA		
Diameter - Inches <u>4"</u>	Length - Feet <u>20'</u>	Slot Size - Inches <u>old 10/10</u>
Screen Type <u>PVC</u>	Depth to Bottom - Feet <u>170'</u>	


GEOLOGIC DATA (Office Use Only)			
Surface Elev.	Geologic Unit	Unit Thickness	Depth to Top
Subs. SWL	Date	Analysis	Aquifer Test
Driller's Remarks			
Top of Lap Pipe or Reduction in Casing FEET <input type="checkbox"/> IF TELESCOPED OR MORE THAN ONE SCREEN: USE BACK PAGE			

DESCRIPTION OF FORMATIONS ENCOUNTERED	FROM	TO
<u>Top Soil</u>	<u>0</u>	<u>5</u>
<u>clay</u>	<u>5</u>	<u>30</u>
<u>sand & gravel</u>	<u>30</u>	<u>60</u>
<u>clay</u>	<u>60</u>	<u>120</u>
<u>sand</u>	<u>120</u>	<u>150</u>
<u>course sand</u>	<u>150</u>	<u>170</u>

FORMATIONS (Continued)	FROM	TO
RECEIVED		
JAN 13 1999		
Dept. of Environmental Quality Office of Land & Water Resources		
IF MORE SPACE IS NEEDED, USE BACK		

If well telescopes please
sketch and show depths.

GROUND LEVEL

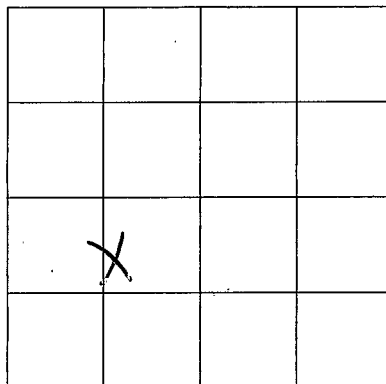

SECTION _____

Please indicate well location X.

ADDITIONAL INFORMATION

If more than one screen,
show location of each on sketch.