

MISSISSIPPI DEPARTMENT OF NATURAL RESOURCES

Bureau of Land and Water Resources

COUNTY WELL LOCATED Lincoln	
WELL NUMBER F 0114	CODED
DATE WELL COMPLETED 1-21-99	

PERMIT NUMBER 510
NAME OF DRILLING FIRM Easley Waterwell
B'haven, MS 39601

P.O. Box 10631
Jackson, Mississippi 39209
WATER WELL DRILLERS LOG

NAME & MAILING ADDRESS OF LANDOWNER Kevin Melton			
WELL LOCATION: SEC	TOWNSHIP	RANGE	
36	7	(N) (E) S W	
DISTANCE	DIRECTION	NEAREST TOWN	
_____ Miles	_____ of _____	_____	
OTHER LANDMARK			
WELL PURPOSE: Home, Irrigation, Municipal, Industrial, Fish Pond, etc.			

PUMP DATA		
PUMP TYPE (Circle One): Submersible , Turbine, Jet, Flowing Well, Other (Describe) _____		
POWER TYPE (Circle One): Electric , Tractor, Diesel, Gasoline, Butane, Other (Describe) _____		
Pump Capacity (GPM)	No. of Stages	Setting, Depth FT.
PUMP TEST		
Well yielded _____ GPM with a drawdown of _____ ft. after _____ hours of pumping		

WELL DATA		
Well Depth 100'	Casing Diameter (In.) 4"	Casing Length (Ft.) 80'
Type of Casing PVC	Hole Depth 100'	Depth to Static Water Level
TYPE OF COMPLETION: (Circle One or More): Natural Development , Gravel Packed, Underreamed, Telescoped, Open Hole, Other (Describe) _____		
Top of Lap Pipe or Reduction in Casing FEET IF TELESCOPED OR MORE THAN ONE SCREEN: USE BACK PAGE		

LOG DATA	
TYPE OF LOG RUN (Circle One): Electric , Gamma Ray, Density, Sonic, Neutron, Other (Describe) _____	
Name of Organization Running Log	


SCREEN DATA		
Diameter - Inches 4"	Length - Feet 20'	Slot Size - Inches 010
Screen Type PVC	Depth to Bottom - Feet	

GEOLOGIC DATA (Office Use Only)			
Surface Elev.	Geologic Unit	Unit Thickness	Depth to Top
Subs. SWL	Date	Analysis	Aquifer Test

Driller's Remarks

DESCRIPTION OF FORMATIONS ENCOUNTERED	FROM	TO
Clay	0	20
Gravel	20	60
Clay	60	80
Sand	80	100

FORMATIONS (Continued)

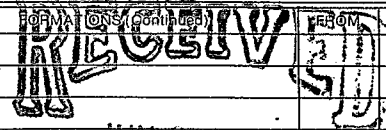


JUN 22 1999

**Dept. of Environmental Quality
Office of Land & Water Resources**

IF MORE SPACE IS NEEDED, USE BACK

If well telescopes please
sketch and show depths.

GROUND LEVEL

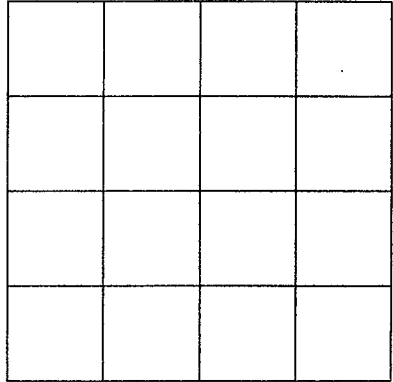

SECTION _____

Please indicate well location X.

ADDITIONAL INFORMATION

Multiple horizontal lines for providing additional information.

If more than one screen,
show location of each on sketch.