

MISSISSIPPI DEPARTMENT OF ENVIRONMENTAL QUALITY

Office of Land and Water Resources

P. O. Box 10631
Jackson, MS 39289-0631
WATER WELL DRILLERS LOG

COUNTY WELL LOCATED <u>Lincoln</u>	
WELL NUMBER <u>F-2128</u>	CODED
DATE WELL COMPLETED <u>10-7-00</u>	

PERMIT NUMBER <u>Green Water Well & Supply</u>
NAME OF DRILLING FIRM <u>1318 Piedale Dr. SE</u>
<u>Bogue Chitto, MS 39029</u>

NAME & MAILING ADDRESS OF LANDOWNER <u>Curtis Smith</u>			
<u>1575 Friendship Ln</u>			
<u>Brookhaven</u>			
WELL LOCATION	SEC	TOWNSHIP	RANGE
	<u>10</u>	<u>7</u> ^N / _S	<u>6</u> ^E / _W
DISTANCE	DIRECTION	NEAREST TOWN	
<u>6</u> Miles	<u>West</u>	of <u>Brookhaven</u>	
OTHER LANDMARK			
WELL PURPOSE <input checked="" type="checkbox"/> Home Irrigation, <input type="checkbox"/> Municipal, <input type="checkbox"/> Industrial, <input type="checkbox"/> Fish Pond, etc.			

PUMP DATA			
PUMP TYPE (Circle One): Submersible, Turbine, Jet, Flowing Well. Other (Describe) _____			
POWER TYPE (Circle One): Electric, Tractor, Diesel, Gasoline, Butane. Other (Describe) _____ H/P <u>12</u>			
Pump Capacity (GPM) <u>10</u>	No of Stages <u>9</u>	Setting Depth <u>79</u> FT.	
PUMP TEST			
Well yielded <u>10</u> GPM with a drawdown of <u>4</u> ft. after <u>1</u> hours of pumping			

Well Depth <u>80</u>	Casing Diameter (In) <u>4</u>	Casing Length (Ft) <u>60</u>
Type of Casing <u>PVC</u>	Hole Depth <u>90</u>	Depth to Static Water Level <u>59</u>

LOG DATA			
TYPE OF LOG RUN (Circle One): Electric, Gamma Ray, Density, Sonic, Neutron, Other (Describe) _____			
<input checked="" type="checkbox"/> No Log Run.			
Name of Organization Running Log			

TYPE OF COMPLETION: (Circle One or More):
 Gravel Packed, Underreamed, Telescoped,
 Natural Development, Open Hole, Other
 (Describe) _____

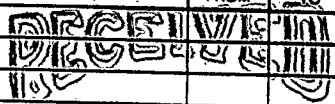
GEOLOGIC DATA (Office Use Only)			
Surface Elev.	Geologic Unit	Unit Thickness	Depth to Top
Subs SWL	Date	Analysis	Aquifer Test

WELL GROUTED TO A DEPTH OF 10 **FEET**
 Type Grout (circle one): Cement, Bentonite, or Mix

Driller's Remarks			
Top of Lap Pipe or Reduction in Casing			
FEET		IF TELESCOPED OR MORE THAN ONE SCREEN: USE BACK PAGE	

Diameter - inches <u>4</u>	Length - Feet <u>20</u>	Slot Size - inches <u>.010</u>
Screen Type <u>PVC</u>		Depth to Bottom - Feet <u>80</u>

DESCRIPTION OF FORMATIONS ENCOUNTERED	FROM	TO	FORMATIONS (Continued)	
			FROM	TO
<u>Sand & Gravel</u>	<u>0</u>	<u>80</u>		
<u>Yellow Clay</u>	<u>80</u>	<u>90</u>		


 MAR 10 2001
 Dept of Environmental Quality
 Office of Land & Water Resources

IF MORE SPACE IS NEEDED, USE BACK

If well telescopes please sketch and show depths.

GROUND LEVEL

			X

SECTION 10

Please indicate well location X.

ADDITIONAL INFORMATION

If more than one screen,
show location of each on sketch.