

MISSISSIPPI DEPARTMENT OF ENVIRONMENTAL QUALITY

Office of Land and Water Resources

P. O. Box 10631
Jackson, MS 39289-0631
WATER WELL DRILLERS LOG

COUNTY WELL LOCATED <u>Lincoln</u>	
WELL NUMBER <u>319548</u>	CODED
<u>F-2130</u>	
DATE WELL COMPLETED <u>12-6-00</u>	

PERMIT NUMBER <u>310</u>
NAME OF DRILLING FIRM <u>Easley Waterwell</u>
<u>Brookhaven MS 39601</u>

NAME & MAILING ADDRESS OF LANDOWNER <u>Chris Hodges</u>			
<u>2542 Zetus Rd</u>			
<u>Brookhaven MS 39601</u>			
WELL LOCATION.	SEC	TOWNSHIP	RANGE
	<u>15</u>	<u>7</u>	<u>N S L W</u>
DISTANCE	DIRECTION	NEAREST TOWN	
Miles _____ of _____			
OTHER LANDMARK			
WELL PURPOSE: <input checked="" type="radio"/> Home, Irrigation, Municipal, Industrial, Fish Pond, etc.			

PUMP DATA			
PUMP TYPE (Circle One): <input checked="" type="radio"/> Submersible, Turbine, Jet, Flowing Well, Other (Describe) _____			
POWER TYPE (Circle One): <input checked="" type="radio"/> Electric, Tractor, Diesel, Gasoline, Butane, Other (Describe) _____ H/P _____			
Pump Capacity (GPM)	No. of Stages	Setting Depth	
		FT.	
PUMP TEST			
Well yielded _____ GPM with a drawdown of _____ ft. after _____ hours of pumping			

WELL DATA		
Well Depth <u>320'</u>	Casing Diameter (In.) <u>4"</u>	Casing Length (Ft.) <u>300'</u>
Type of Casing <u>PVC</u>	Hole Depth	Depth to Static Water Level
TYPE OF COMPLETION: (Circle One or More): <input checked="" type="radio"/> Gravel Packed, <input type="radio"/> Underreamed, <input type="radio"/> Telescoped, <input checked="" type="radio"/> Natural Development, <input type="radio"/> Open Hole, <input type="radio"/> Other		

LOG DATA	
TYPE OF LOG RUN (Circle One): <input type="radio"/> No Log Run, <input type="radio"/> Electric, <input type="radio"/> Gamma Ray, <input type="radio"/> Density, <input type="radio"/> Sonic, <input type="radio"/> Neutron, Other (Describe) _____	
Name of Organization Running Log	

WELL GROUTED TO A DEPTH OF <u>10</u> FEET	
Type Grout (circle one): <input checked="" type="radio"/> Cement, <input type="radio"/> Bentonite, or Mix	

GEOLOGIC DATA (Office Use Only)			
Surface Elev.	Geologic Unit	Unit Thickness	Depth to Top
Subs. SWL	Date	Analysis	Aquifer Test
Driller's Remarks			

SCREEN DATA		
Diameter - Inches <u>4"</u>	Length - Feet <u>20'</u>	Slot Size - Inches <u>0-10</u>
Screen Type <u>PVC</u>	Depth to Bottom - Feet	

FEET		IF TELESCOPED OR MORE THAN ONE SCREEN: USE BACK PAGE
Top of Lap Pipe or Reduction in Casing		


DESCRIPTION OF FORMATIONS ENCOUNTERED	FROM	TO
<u>Clay</u>	<u>0</u>	<u>20</u>
<u>Shale</u>	<u>20</u>	<u>75</u>
<u>Clay</u>	<u>75</u>	<u>300</u>
<u>Sand</u>	<u>300</u>	<u>320</u>

FORMATIONS (Continued)	FROM	TO

REC'D JUN 13 2001

If well telescopes please
sketch and show depths.

GROUND LEVEL

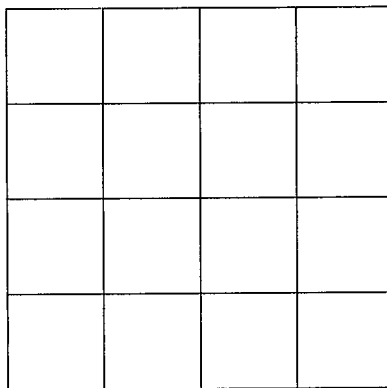

SECTION _____

Please indicate well location X.

ADDITIONAL INFORMATION

If more than one screen,
show location of each on sketch.