

Lincoln
G
9-26-79

MISSISSIPPI
BOARD OF WATER COMMISSIONERS
416 North State Street
Jackson, Mississippi 39201

WATER WELL DRILLERS LOG

Sept. 26 1979 Grenn Water Well Cont. Lincoln
date well completed firm name county well located

LANDOWNER:	description of formations encountered	from	to
George Gulley Jr.			
Brookhaven, Ms.	sand	15	42
(mailing address)	white clay	42	48
	blue clay	48	70
	sand	70	130
WELL LOCATION: sec. 25 T 7 N R 7 E 1 miles S of Brookhaven (distance) (direction) (nearest town)			
WELL PURPOSE: Cemetery (home, irrigation, municipal, industrial)			
WELL COMPLETION DATA:			
(1) diameter (inches) 6			
(2) total depth (feet) 130			
(3) static water level (feet) 0 below above top of ground.			
(4) casing PVC, 120 (material), (depth), 4" (size) if telescope see back.			
(5) screen 10' 120' (length), (depth to top), .010 PVC (size), (material)			
(6) pump did not install (HP) (yield gpm)			
(type power)			
(7) electric log no (yes or no)			
(organization running log)			
(8) how well bottom plugged back wash valve			
DRILLERS REMARKS:			

DEPT. OF NATURAL RESOURCES
BUREAU OF LAND & WATER RESOURCES


NOV 20 1979

RECEIVED

②

If well telescopes please sketch and show depths.

GROUND LEVEL

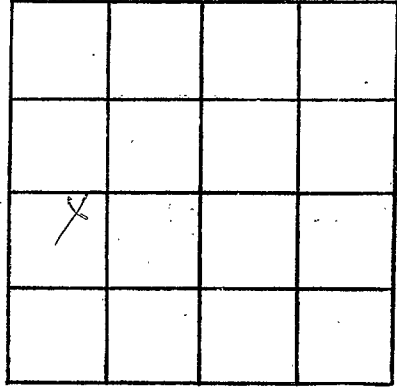

SECTION 25

Please indicate well location X.

ADDITIONAL INFORMATION

If more than one screen, show locations of each on sketch.