

Lincoln
 G3 CODED
 8-67

MISSISSIPPI
 BOARD OF WATER COMMISSIONERS
 416 North State Street
 Jackson, Mississippi 39201

WATER WELL DRILLERS LOG

8-22-1967 Stephens Well Serv Lincoln
 date well completed firm name county well located

LANDOWNER: Mr. H.R. Owens
Rt 2 Brookhaven Miss

description of formations encountered	from	to
Top soil & clay	0	10
Red sand	10	50
Sandy gravel	50	60
Chalk, White Blue	60	110
Sand & gravel	110	150


(mailing address)

WELL LOCATION:
 sec 21 T 7 N R 7 E
4 miles W of Brookhaven
 (distance) (direction) (nearest town)

WELL PURPOSE: Home
 (home, irrigation, municipal, industrial)

- WELL COMPLETION DATA:
- (1) diameter (inches) 4
 - (2) total depth (feet) 150
 - (3) static water level (feet) 60 below top of ground.
 - (4) casing plastic 1 1/4 (material) (depth)
4 (size) If telescope see back.
 - (5) screen 6' (length) 1 1/4 (depth to top)
1/2" (size) plastic (material)
 - (6) pump 1 Jet 8 (HP) (yield gpm)
Free (type power)
 - (7) electric log No (yes or no)
 - (8) how well bottom plugged Hard Peg


CODED

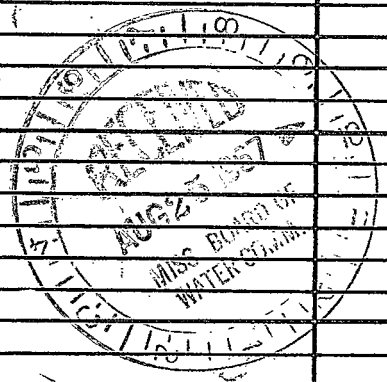

DRILLERS REMARKS: Original
Well 60' became salty
new well was grouted
at 85'

If well telescopes please sketch and show depths.

GROUND LEVEL

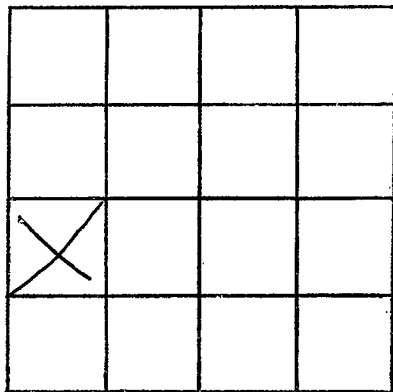

SECTION 24

Please indicate well location X.

ADDITIONAL INFORMATION

If more than one screen,
show locations of each on sketch.