

Lincoln
G4
11-67

MISSISSIPPI
BOARD OF WATER COMMISSIONERS
416 North State Street
Jackson, Mississippi 39201

WATER WELL DRILLERS LOG

11-18 1967 date well completed
W. Edwards Water Well Drilling firm name
Lincoln county well located

LANDOWNER: J.C. Urban
Brookhaven, Miss
(mailing address)

WELL LOCATION:
sec 24 T 2 N R 2 E
S W
1/2 miles S of Brookhaven
(distance) (direction) (nearest town)

WELL PURPOSE:
(home, irrigation, municipal, industrial)

WELL COMPLETION DATA:

(1) diameter (inches) 4

(2) total depth (feet) 163

(3) static water level (feet) 50 below top of ground.

(4) casing plastic 155 (material) (depth)
4 (size) if telescope see back.

(5) screen 81 155 (length) (depth to top)
4 plastic (size) (material)


(6) pump (HP) (yield gpm)
Elex (type power)

(7) electric log (yes or no)
(organization running log)

(8) how well bottom plugged wood peg

description of formations encountered	from	to
Top soil & clay	0	16
Gravel band	16	28
Heavy gravel	28	35
Sand	35	45
Wash sand	45	52
White Chalk	52	104
Fine sand	104	150
Coarse Sand	150	162


white Chalk 63

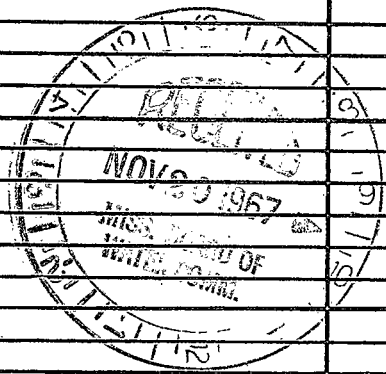

DRILLERS REMARKS:

If well telescopes please sketch and show depths.

GROUND LEVEL

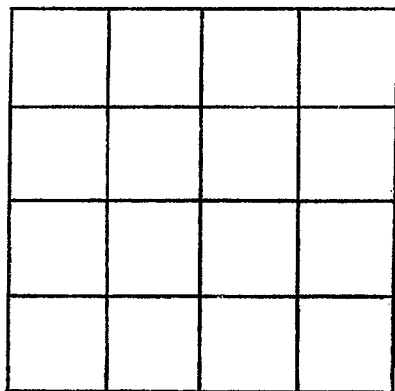

SECTION _____

Please indicate well location X.

ADDITIONAL INFORMATION

If more than one screen,
show locations of each on sketch.