

LINCOLN

G6

MISSISSIPPI BOARD OF WATER COMMISSIONERS

CODED

4-1-66

3060
3328

CODED

WATER WELL DRILLERS LOG

Date: 4-1, 1966, Driller: Chester Reeves County: Lauderdale
(When well drilled) (Name) (Where well is located)

(1) Owner of Land: D. L. Green
(Name)
Brookhaven
(Address)

(2) Location: South of Brookhaven
1/4 Sec. 24 77
1/4 Sec. 77 J.R.
(distance) (direction) (Nearest Town)

(3) Topography: Flat
(Hilly) (Flat) (Level)

(4) Purpose of Well: Domestic
(Domestic Irrigation
Municipal, Industrial, Other)

Description & Color of Materials Sand, Clay, Red Clay, Shell, etc.	Thick- ness Feet	Depth Feet
<u>Red clay</u>	<u>15</u>	<u>15</u>
<u>Yellow sand</u>	<u>30</u>	<u>45</u>
<u>White shell</u>	<u>55</u>	<u>100</u>
<u>Red sand</u>	<u>30</u>	<u>130</u>
<u>Coarse white sand</u>	<u>25</u>	<u>155</u>

Information upon completion of well:

(1) Diameter: 4 inches.

(2) Total Depth: 155 feet.


(3) Water Level: 60 feet below top of ground.

(4) Cased to: bottom, Size 4"

(5) Screen: Size 1 1/2", Length 12'

(6) Were any formations sealed against pollution?
yes, no.

CODED

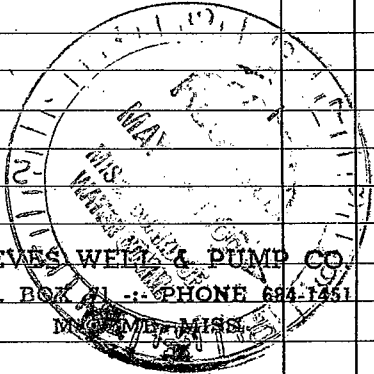

REEVES WELL & PUMP CO.
P. O. BOX 41 - PHONE 684-1451
DUMPER, MISS.

Drillers Remarks: NO PREVIOUS WELL

Yield in gpm: 15 - Kumpell

Size pump: 1 HP Sub

Type power: Electric

