

Lincoln
 67 CODED
 5-68

MISSISSIPPI
 BOARD OF WATER COMMISSIONERS
 416 North State Street
 Jackson, Mississippi 39201

CODED

WATER WELL DRILLERS LOG

May 20 1968 *Sevens Well Drilling* *Lincoln*
 date well completed firm name county well located

LANDOWNER: *Paul Darbonne*
PO Box 3000
Baybrookham
 (mailing address)

description of formations encountered	from	to
<i>clay</i>	<i>0</i>	<i>12</i>
<i>red sand</i>	<i>12</i>	<i>60</i>
<i>Regravel sand</i>	<i>60</i>	<i>72</i>
<i>white chalk</i>	<i>72</i>	<i>106</i>
<i>fine sand</i>	<i>106</i>	<i>118</i>
<i>Regravel sand</i>	<i>118</i>	<i>126</i>

WELL LOCATION:
 sec. *7* T. *7* N. R. *7* E
5 miles *W* of *Baybrookham*
 (distance) (direction) (nearest town)

WELL PURPOSE: *trailer*
 (home, irrigation, municipal, industrial)

WELL COMPLETION DATA:

- (1) diameter (inches) *4"*
- (2) total depth (feet) *126*
- (3) static water level (feet) *56* below top of ground.
- (4) casing *Plastic bottom*
 (material) (depth)
- (5) screen *6'* *120'*
 (length) (depth to top)
4" *Plastic*
 (size) (material)
- (6) pump *1/2 HP* *12*
 (HP) (yield gpm)
elect
 (type power)
- (7) electric log *no*
 (yes or no)

sampled in this vicinity this 60-72 ft formation is sandy

JUL 17 1968
 MISS. BOARD OF WATER COMMISSIONERS


(organization running log)

(8) how well bottom plugged
wood chips

DRILLERS REMARKS:
new location

If well telescopes please sketch and show depths.

GROUND LEVEL

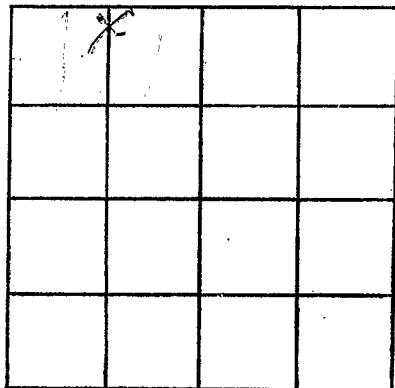

SECTION 17

Please indicate well location X.

ADDITIONAL INFORMATION

If more than one screen, show locations of each on sketch.