

~~B-49~~ CODED

10/17/68

9-27-61

WATER WELL DRILLERS LOG

Date: 9-27, 1961, Driller Chester Reeves County Lincoln
 (Name)

(1) Owner of Land	<u>Sidney^A Smith</u> <small>(Name)</small>	Description & Color of Materials Sand, Clay, Red Clay, Shell, etc.	Thick- ness Feet
<u>RFD</u>	<u>Brookhaven</u> <small>(Address)</small>	<u>yellow clay gravel mixed with blue & white chalk</u>	<u>10</u> <u>80</u>
(2) Location:	<u>1/4</u> , <u>1/4</u> , Sec. <u>8</u> T <u>7</u> R <u>7</u> <small>(direction) (Nearest Town)</small> <u>11</u> miles <u>N-west</u> of <u>Brookhaven</u> <small>(distance) (direction) (Nearest Town)</small>	<u>fine sand blue chalk fine white sand</u>	<u>25</u> <u>5</u> <u>30</u>
(3) Topography:	<u>Hilly</u> <small>(Hilly) (Flat) (Level)</small>		
(4) Purpose of Well:	<u>Domestic</u> <small>(Domestic Irrigation Municipal, Industrial, Other)</small>		<u>150</u>

Information upon completion of well:


- (1) Diameter 2 inches.
- (2) Total Depth 150 feet.
- (3) Water Level 92 feet below top of ground.
- (4) Cased to Bottom, Size 2"
- (5) Screen: Size 1 1/4", Length 6'
- (6) Were any formations sealed against pollution?
 yes, no.

If YES depth of formation _____
 Why _____

Drillers Remarks: old well
Dry at 40ft

~~Cannot locate~~
R.V.

CODED

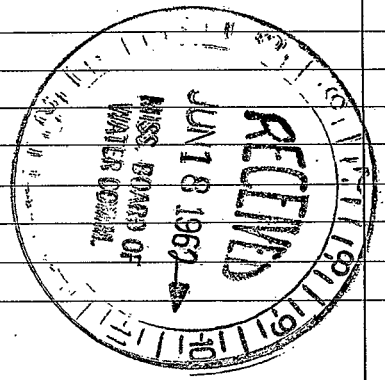

(Use Back Side)

Handwritten notes and scribbles at the top of the page, including the word "MAY" and other illegible markings.

Large area of very faint and illegible handwritten text in the middle of the page.

Handwritten notes at the bottom of the page, including the word "MAY" and other illegible markings.