

OK 92R
10/17/68

MISSISSIPPI
BOARD OF WATER COMMISSIONERS
416 North State Street
Jackson, Mississippi 39201

WATER WELL DRILLERS LOG

Lincoln
G11
3-67

CODED

CODED

March 3 1967 date well completed
Fitzgerald Well Drilling Lincoln firm name
Lincoln county well located

LANDOWNER: Sheldon Dow

description of formations encountered	from	to
Brown clay	0	10
Red sand	10	50
Red sand & gravel	50	75
Red chalk	75	80
Coarse sand	80	90
Coarse sand & gravel	90	100

R Route, Brookline, (mailing address)


WELL LOCATION:
sec. G11 K No. 11 W. E
5 miles S 55-7 W 7 of Brookline
(distance) (direction) (nearest town)

WELL PURPOSE: Home
(home, irrigation, municipal, industrial)

WELL COMPLETION DATA:

- (1) diameter (inches) 4
- (2) total depth (feet) 100
- (3) static water level (feet) 65 below top of ground.
- (4) casing Plastic, 92' (material) (depth)
4" (size) if telescope see back.
- (5) screen 8' , 92' (length) (depth to top)
4" , Plastic (size) (material)
- (6) pump P ? (HP) (yield gpm)
Electric (type power)
- (7) electric log No (yes or no)
(organization running log)
- (8) how well bottom plugged about 1/2


CODED

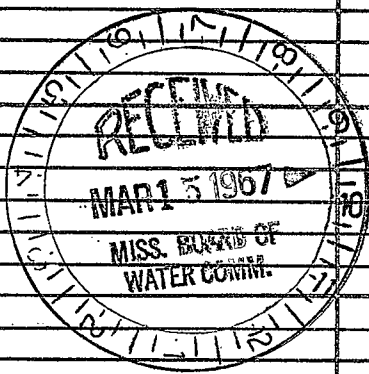

DRILLERS REMARKS:

If well telescopes please sketch and show depths.

GROUND LEVEL

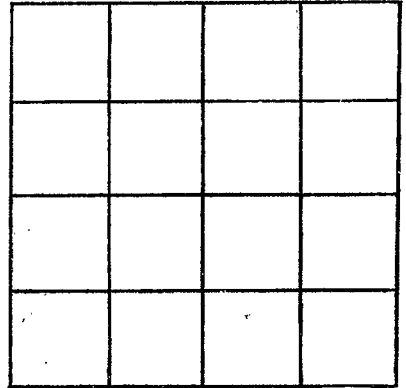

SECTION _____

Please indicate well location X.

ADDITIONAL INFORMATION

If more than one screen,
show locations of each on sketch.