

CODED

MISSISSIPPI
BOARD OF WATER COMMISSIONERS
416 North State Street
Jackson, Mississippi 39201

coded

WATER WELL DRILLERS LOG

Lincoln
G 13
7-68

7 31 1968 Fitzgerald Water Well Lincoln
date well completed firm name county well located

LANDOWNER: Standard Oil Co

description of formations encountered

from to

Brookhaven Miss

Top soil & clay 0 12
Gravel loose 12 33
White & Blue Chalk 33 90
Medium coarse sand 90 120

(mailing address)

WELL LOCATION:

sec 34 T 7 N R 7 E
S W
5 miles SW of Brookhaven
(distance) (direction) (nearest town)

WELL PURPOSE: Filling station
(home, irrigation, municipal, industrial)

WELL COMPLETION DATA:


- (1) diameter (inches) 4
- (2) total depth (feet) 118
- (3) static water level (feet) 20 below above top of ground.
- (4) casing plastic, 110
(material), (depth)
 if telescope see back.
(size)
- (5) screen 81, 110
(length) (depth to top)
4, Sch HD
(size) (material)
- (6) pump _____ (HP) _____ (yield gpm)
(type power)

(7) electric log NO
(yes or no)

(organization running log)


(8) how well bottom plugged peg

DRILLERS REMARKS:

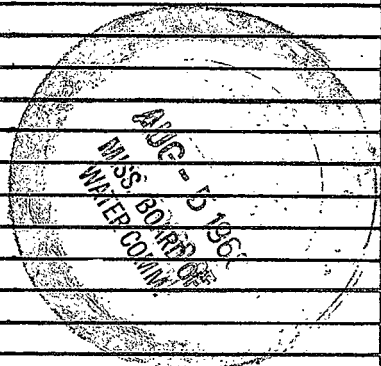

If well telescopes please sketch and show depths.

GROUND LEVEL

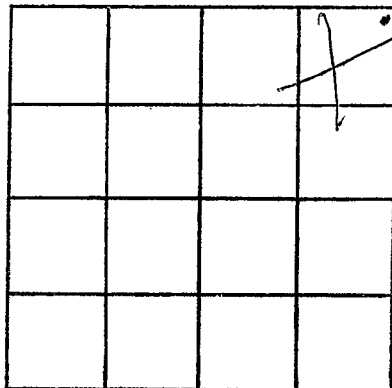

SECTION 34

Please indicate well location X.

ADDITIONAL INFORMATION

If more than one screen, show locations of each on sketch.