

*Lincoln*  
*G-14*  
*10-12-68*


MISSISSIPPI  
 BOARD OF WATER COMMISSIONERS  
 416 North State Street  
 Jackson, Mississippi 39201

CODED

WATER WELL DRILLERS LOG


*10-12* 19*68* *Fitzgerald well serv* *Lincoln*  
 date well completed firm name county well located

LANDOWNER:	description of formations encountered	from	to
<i>Texas Service Station</i>	<i>Red Clay</i>	<i>0</i>	<i>10</i>
<i>B.R. Brookborn Miss.</i>	<i>Red gravel</i>	<i>10</i>	<i>20</i>
(mailing address)	<i>White clay</i>	<i>20</i>	<i>85</i>
WELL LOCATION:	<i>Coarse sand</i>	<i>85</i>	<i>115</i>
sec. <i>27</i> T. <i>7</i> N. R. <i>7</i> E.	<i>Coarse sand &amp; gravel</i>	<i>115</i>	<i>136</i>
S W			<i>65</i>
<i>2</i> miles <i>SW</i> of <i>Brookborn</i>			<i>51</i>
(distance) (direction) (nearest town)			
WELL PURPOSE:			
(home, irrigation, municipal, industrial)			
WELL COMPLETION DATA:			
(1) diameter (inches) <i>4</i>			
(2) total depth (feet) <i>136</i>			
(3) static water level (feet) <i>25</i> below top of ground.			
(4) casing <i>Plastic</i> <i>130</i>			
(material) (depth)			
<i>4</i> if telescope see back.			
(size)			
(5) screen <i>6</i> <i>130</i>			
(length) (depth to top)			
<i>4</i> <i>Plastic</i>			
(size) (material)			
(6) pump <i>7</i> <i>7</i>			
(HP) (yield gpm)			
<i>900</i>			
(type power)			
(7) electric log <i>Yes</i>			
(yes or no)			
(organization running log)			
(8) how well bottom plugged <i>2 steel p</i>			
DRILLERS REMARKS:			

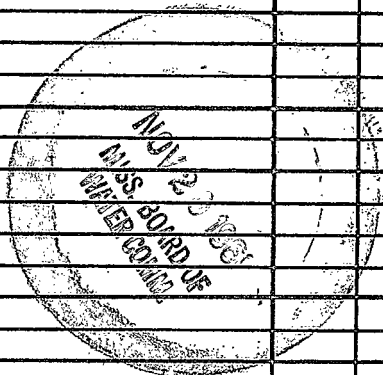

If well telescopes please  
sketch and show depths.

GROUND LEVEL

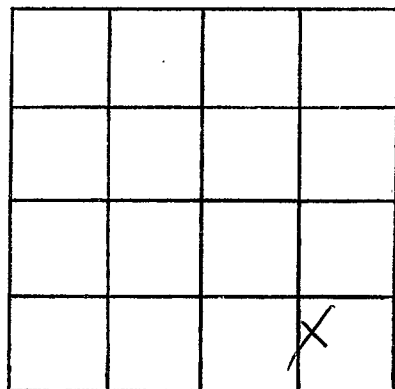

SECTION 27

Please indicate well location X.

ADDITIONAL INFORMATION

If more than one screen,  
show locations of each on sketch.