

**MISSISSIPPI
BOARD OF WATER COMMISSIONERS**
416 North State Street
Jackson, Mississippi 39201

CODED

WATER WELL DRILLERS LOG

5-25
date well completed

19 69 Fitzgerald well drill
firm name

Lincoln
county well located

LANDOWNER:

Tanner Williams

R.R. Brookdown, Miss.
(mailing address)

WELL LOCATION:

sec. 14 T. 7 N R. 7 E
S W
1 miles W of Brookdown
(distance) (direction) (nearest town)

WELL PURPOSE: Home
(home, irrigation, municipal, industrial)

WELL COMPLETION DATA:

- (1) diameter (inches) 4
- (2) total depth (feet) 174
- (3) static water level (feet) 50 below above top of ground.
- (4) casing Plastic 168,
(material) (depth)
4 If telescope see back.
(size)
- (5) screen 6 168
(length) (depth to top)
4 Plastic
(size) (material)
- (6) pump ? ?
(HP) (yield gpm)
Elco
(type power)
- (7) electric log sg
(yes or no)
(organization running log)
- (8) how well bottom plugged steel peg

description of formations encountered

from to

description of formations encountered	from	to
<u>red clay</u>	<u>6</u>	<u>20</u>
<u>fine sand</u>	<u>20</u>	<u>50</u>
<u>fine sand</u>	<u>50</u>	<u>80</u>
<u>white + blue clay</u>	<u>80</u>	<u>150</u>
<u>fine sand</u>	<u>150</u>	<u>180</u>
<u>coarse sand</u>	<u>160</u>	<u>174</u>


DRILLERS REMARKS:

MISS. BD. OF
WATER COMMISSIONERS

JUN 2 - 1969

If well telescopes please sketch and show depths.

GROUND LEVEL

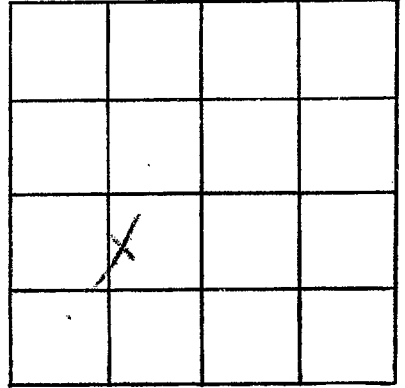

SECTION 14

Please indicate well location X.

ADDITIONAL INFORMATION

If more than one screen, show locations of each on sketch.