

Lincoln  
G 17  
9-8-69

MISSISSIPPI  
BOARD OF WATER COMMISSIONERS  
416 North State Street  
Jackson, Mississippi 39201

WATER WELL DRILLERS LOG

8 Sept. 1969 J. T. Carwright & Son Lincoln  
date well completed firm name county well located

LANDOWNER:  
Lewis Norton  
Brookhaven  
(mailing address)

WELL LOCATION:  
sec. 11 T-7N R-7E  
3 miles west of Brookhaven  
(distance) (direction) (nearest town)

description of formations encountered	depth	
	from	to
Clay	0	30
Sand shell	30	70
Clay	70	75
Sand	75	125

WELL PURPOSE:  
(home, irrigation, municipal, industrial)

WELL COMPLETION DATA:

(1) diameter (inches) 4"

(2) total depth (feet) 125

(3) static water level (feet) 70 ~~above~~ below top of ground

(4) casing Plastic, 125,  
(material) (depth)  
(size) If telescope see back.

(5) screen 6', 119  
(length) (depth to top)  
4", PVC  
(size) (material)

(6) pump 1/2, 9  
(HP) (yield gpm)  
Electric  
(type power)

(7) electric log NO  
(yes or no)  
(organization running log)

(8) how well bottom plugged wood


OCT 15 1969

MISS. BD. OF  
WATER COMM.

DRILLERS REMARKS:

If well telescopes please sketch and show depths.

GROUND LEVEL

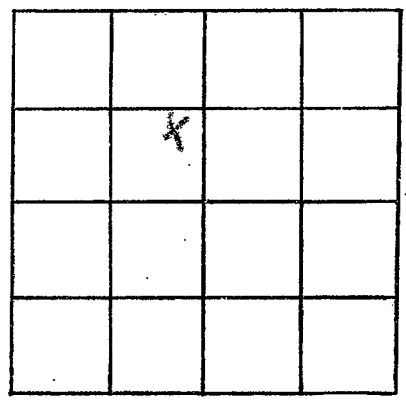

SECTION 11

Please indicate well location X.

ADDITIONAL INFORMATION

Lined area for additional information.

If more than one screen, show locations of each on sketch.