

LINCOLN
G 18
11-13-69

MISSISSIPPI
BOARD OF WATER COMMISSIONERS
416 North State Street
Jackson, Mississippi 39201

CODED

WATER WELL DRILLERS LOG

11-13
date well completed

1969 F. Fitzgerald
firm name

Lincoln
county well located

LANDOWNER:

Roland Capet

RR. Beekman Miss.
(mailing address)

WELL LOCATION:

sec. 20 T 7 N R 7 E
S W
2 1/2 miles W of Beekman
(distance) (direction) (nearest town)

WELL PURPOSE:

Home
(home, irrigation, municipal, industrial)

WELL COMPLETION DATA:

- (1) diameter (inches) 4
- (2) total depth (feet) 164
- (3) static water level (feet) 60 below top of ground.
- (4) casing (material) 156 (depth)
4 (size) if telescope see back.
- (5) screen 3 (length) 156 (depth to top)
4 (size) (material)
- (6) pump ? (HP) ? (yield gpm)
? (type power)
- (7) electric log (yes or no)
- (organization running log)
- (8) how well bottom plugged lined

description of formations encountered

from

to

description of formations encountered	from	to
Red clay	6	20
Red sand	20	40
Red gravel	40	56
white clay	56	140
Coarse sand	140	164

CODED

NOV 21 1969


DRILLERS REMARKS:

MISS. BD. OF
WATER COM.

If well telescopes please sketch and show depths.

12

GROUND LEVEL

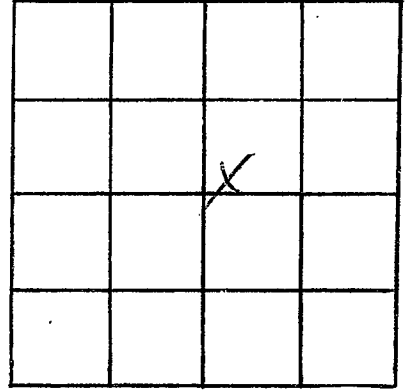

SECTION 20

Please indicate well location X.

ADDITIONAL INFORMATION

If more than one screen,
show locations of each on sketch.