

LINCOLN  
G22  
9-13-71

MISSISSIPPI  
 BOARD OF WATER COMMISSIONERS  
 416 North State Street  
 Jackson, Mississippi 39201

WATER WELL DRILLERS LOG

**CODED**

Sept 13 1971 Green water well Lincoln  
 date well completed firm name county well located

LANDOWNER: <u>Anthony Smith</u>	description of formations encountered	from	to
<u>Rt 5 Brookhaven</u> <u>39601</u> (mailing address)	<u>Citronelle</u>	<u>0</u>	<u>93</u>
	<u>Blue clay</u>	<u>93</u>	<u>170</u>
	<u>yellow sand</u>	<u>170</u>	<u>218</u>
	<u>Blue clay</u>	<u>218</u>	<u>240</u>
<b>WELL LOCATION:</b> sec <u>31</u> T <u>7</u> S R <u>7</u> W <u>6</u> miles <u>W</u> of <u>Brookhaven</u> (distance) (direction) (nearest town)			
<b>WELL PURPOSE:</b> <u>Home</u> (home, irrigation, municipal, industrial)			
<b>WELL COMPLETION DATA:</b>			
(1) diameter (inches) <u>6</u>			
(2) total depth (feet) <u>240</u>			
(3) static water level (feet) <u>60</u> below top of ground.			
(4) casing <u>PVC</u> , <u>186</u> , (material) (depth)			
(size) if telescope see back.			
(5) screen <u>6'</u> , <u>180</u> (length) (depth to top)			
<u>010</u> , (size) (material)			
(6) pump <u>no</u> (HP) (yield gpm)			
(type power)			
(7) electric log <u>no</u> (yes or no)			
(organization running log)			
(8) how well bottom plugged <u>wood</u>			
<b>DRILLERS REMARKS:</b>			


**CODED**

OCT 25 1971

MISS. BO. OF  
 WATER COMMISSIONERS

If well telescopes please sketch and show depths.

GROUND LEVEL

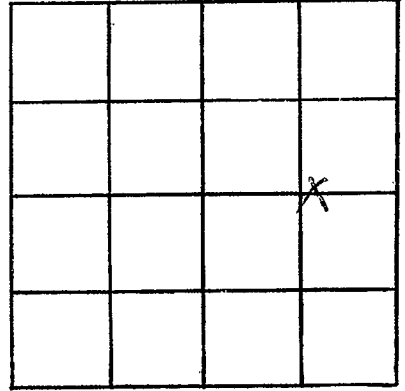

SECTION 31

Please indicate well location X.

ADDITIONAL INFORMATION

If more than one screen, show locations of each on sketch.