

LINCOLN
G23
9-20-71

MISSISSIPPI
 BOARD OF WATER COMMISSIONERS
 416 North State Street
 Jackson, Mississippi 39201

WATER WELL DRILLERS LOG

CODEN

Sept. 20 1971 Ground water well Lincoln
 date well completed firm name county well located

LANDOWNER: Bob Graubman

description of formations encountered

from to

Field Lark Lane

Brookhaven, Miss
 (mailing address)

| | | |
|--------------------------|------------|------------|
| <u>Citronelle</u> | <u>1</u> | <u>74</u> |
| <u>White Clay</u> | <u>74</u> | <u>100</u> |
| <u>Green sand + clay</u> | <u>100</u> | <u>124</u> |
| <u>Blue clay</u> | <u>124</u> | <u>130</u> |

WELL LOCATION:

sec. 3 T. 7 N. R. 7 E
1/4 miles N.W. of Brookhaven
 (distance) (direction) (nearest town)

WELL PURPOSE: Home
 (home, irrigation, municipal, industrial)

WELL COMPLETION DATA:

- (1) diameter (inches) 6"
- (2) total depth (feet) 130
- (3) static water level (feet) 55 below above top of ground.
- (4) casing PVC, 74
 (material) (depth)

 If telescope see back.
 (size)

- (5) screens 6' 68
 (length) (depth to top)

0/0, P.V.C.
 (size) (material)

- (6) pump 1/3 7
 (HP) (yield gpm)

electric
 (type power)

- (7) electric log no
 (yes or no)

 (organization running log)

- (8) how well bottom plugged wood

DRILLERS REMARKS:


CODEN

OCT 25 1971

MISS. BD. OF
 WATER COMMISSIONERS

If well telescopes please sketch and show depths.

GROUND LEVEL

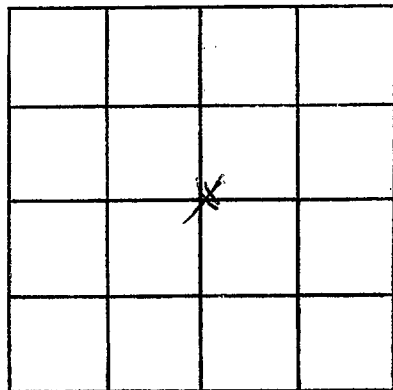

SECTION 3

Please indicate well location X.

ADDITIONAL INFORMATION

If more than one screen,
show locations of each on sketch.