

LINCOLN
G 24
10-25-71

MISSISSIPPI
 BOARD OF WATER COMMISSIONERS
 416 North State Street
 Jackson, Mississippi 39201

DEC 6 1971

WATER WELL DRILLERS

CODED

8-5 Oct 1971
 date well completed

SP Water Well
 firm name

Lincoln
 county well located

LANDOWNER:

Bradly Bigland
 Summit, Miss.
 (mailing address)

description of formations encountered

from to

Clay	0	25
clay sand	25	40
clay	40	55
rock	55	85

WELL LOCATION:

sec. 34 T. 7 S. R. 7 E.
4 miles west of Princeton
 (distance) (direction) (nearest town)

WELL PURPOSE:

(home, irrigation, municipal, industrial)

WELL COMPLETION DATA:

- (1) diameter (inches) 4
- (2) total depth (feet) 85
- (3) static water level (feet) 55 below above top of ground.
- (4) casing PI 79
 (material) (depth)
 (size) if telescope see back.
- (5) screen 6 79
 (length) (depth to top)
4 PI
 (size) (material)
- (6) pump 1/2 8
 (HP) (yield gpm)
sub
 (type power)
- (7) electric log (yes or no) _____

(organization running log)


(8) how well bottom plugged wood

CODED

DRILLERS REMARKS:

If well telescopes please sketch and show depths.

GROUND LEVEL

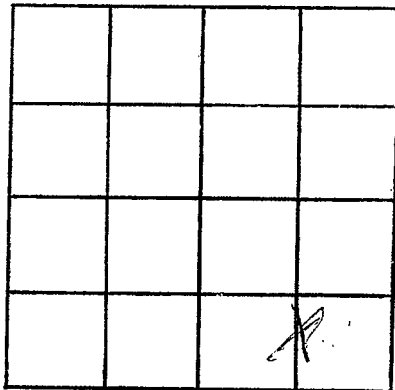

SECTION

34

Please indicate well location X.

ADDITIONAL INFORMATION

If more than one screen,
show locations of each on sketch.