

Lincoln
G 25
11-11-71

MISSISSIPPI
 BOARD OF WATER COMMISSIONERS
 416 North State Street
 Jackson, Mississippi 39201

CODED

WATER WELL DRILLERS LOG

11 Nov 1971 ~~Waterwell~~ Lincoln
 date well completed firm name county well located

LANDOWNER:
Bryant Johnson
Brookhaven Miss
 (mailing address)

WELL LOCATION:
 sec 33 T 7 N R 7 E
S 5 miles west of Brookhaven
 (distance) (direction) (nearest town)

WELL PURPOSE:
 (home, irrigation, municipal, industrial)

- WELL COMPLETION DATA:**
- (1) diameter (inches) 4
 - (2) total depth (feet) 150
 - (3) static water level (feet) 80 below above top of ground.
 - (4) casing PI 142
 (material) (depth)
 (size) if telescope see back.
 - (5) screen 6 142
 (length) (depth to top)
4 PI
 (size) (material)
 - (6) pump 1/2 8
 (HP) (yield gpm)
Shut
 (type power)
 - (7) electric log (yes or no) _____
 (organization running log) _____
 - (8) how well bottom plugged wood

description of formations encountered	from	to
<u>Clay</u>	<u>0</u>	<u>7.5</u>
<u>clay. sand</u>	<u>0</u>	<u>40</u>
<u>chalk</u>	<u>40</u>	<u>50</u>
<u>sand</u>	<u>50</u>	<u>65</u>
<u>Chalk</u>	<u>65</u>	<u>115</u>
<u>sand</u>	<u>115</u>	<u>150</u>

CODED


JAN 19 1972

DRILLERS REMARKS:

MISS. BD. OF
 WATER COM.

If well telescopes please sketch and show depths.

GROUND LEVEL

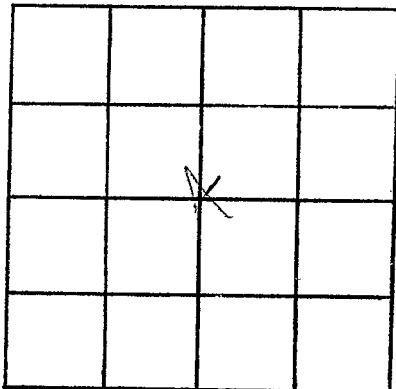

SECTION 23

Please indicate well location X:

ADDITIONAL INFORMATION

If more than one screen,
show locations of each on sketch.