

# CODED

MISSISSIPPI

BOARD OF WATER COMMISSIONERS

416 North State Street

Jackson, Mississippi 39201

## WATER WELL DRILLERS LOG

LINCOLN
G28
4-20-72

4-20 19 72 Greenwater Well Co Lincoln  
 date well completed firm name county well located


LANDOWNER:	description of formations encountered	from	to
<u>Druman William</u>	<u>Clay and sand</u> <sup>red</sup>	<u>0</u>	<u>60</u>
<u>Brookhaven Miss</u> (mailing address)	<u>clay</u> <u>sand</u>	<u>60</u> <u>100</u>	<u>100</u> <u>120</u>
<b>WELL LOCATION:</b>			
sec. <u>9</u> T. <u>7</u> N. R. <u>7</u> E.			
<u>6</u> miles <u>W</u> of <u>Brookhaven</u> (distance) (direction) (nearest town)			
<b>WELL PURPOSE:</b> <u>Home</u> (home, irrigation, municipal, industrial)			
<b>WELL COMPLETION DATA:</b>			
(1) diameter (inches) <u>6"</u>			
(2) total depth (feet) <u>120</u>			
(3) static water level (feet) <u>60</u> below above top of ground.			
(4) casing <u>PVC</u> , <u>105'</u> (material) (depth) <u>4"</u> if telescope see back. (size)			
(5) screen <u>6'</u> , <u>105'</u> (length) (depth to top)			
(6) pump <u>010</u> , <u>PVC</u> (size) (material) <u>did not install</u> (HP) (yield gpm)			
(type power)			
(7) electric log <u>no</u> (yes or no)			
(organization running log)			
(8) how well bottom plugged <u>wood</u>			
<b>DRILLERS REMARKS:</b>			

# CODED

APR 23 1972

If well telescopes please sketch and show depths.

GROUND LEVEL

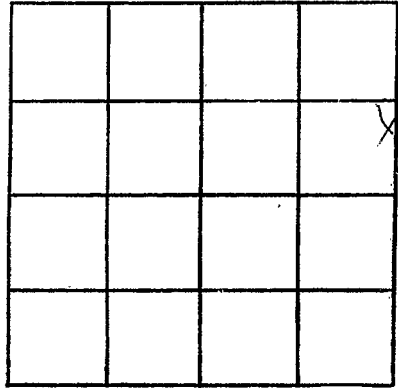

SECTION 9

Please indicate well location X.

ADDITIONAL INFORMATION

A series of horizontal lines for writing additional information, starting below the 'ADDITIONAL INFORMATION' header and extending down to the bottom of the page.

If more than one screen, show locations of each on sketch.