

LINCOLN
G28
2-23-72

MISSISSIPPI
 BOARD OF WATER COMMISSIONERS
 416 North State Street
 Jackson, Mississippi 39201

CODED

WATER WELL DRILLERS LOG

Feb. 23 1972 Green Water well Contractor Lincoln
 date well completed firm name county well located

LANDOWNER:	description of formations encountered	from	to
Kings' Daughters Hospital Brookhaven, Miss. (mailing address)			
	White clay	75	110
	Red sand	110	158
	clay	158	170
	rock	170	
WELL LOCATION:			
sec. <u>12</u> T. <u>7</u> N. R. <u>7</u> E - S- - W.			
0 miles W of Brookhaven (distance) (direction) (nearest town)			
WELL PURPOSE: hospital (home, irrigation, municipal, industrial)			
WELL COMPLETION DATA:			
(1) diameter (inches) <u>6</u>			
(2) total depth (feet) <u>170</u>			
(3) static water level (feet) <u>55</u> below above top of ground.			
(4) casing <u>PVC</u> <u>140</u> (material) (depth) <u>4"</u> (size) if telescope see back.			
(5) screen <u>15 ft.</u> <u>140</u> (length) (depth to top) <u>.010</u> <u>PVC</u> (size) (material)			
(6) pump <u>5 HP Sub.</u> <u>60</u> (HP) (yield gpm) <u>electric</u> (type power)			
(7) electric log <u>no</u> (yes or no) (organization running log)			
(8) how well bottom plugged <u>wood</u>			
DRILLERS REMARKS:			

CODED


APR 25 1972

MISS. P.
 NUMBER 105



If well telescopes please sketch and show depths.

GROUND LEVEL

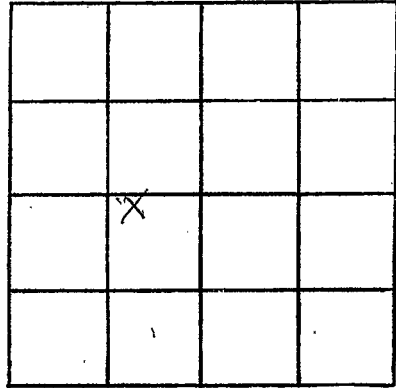

SECTION 12

Please indicate well location X.

ADDITIONAL INFORMATION

Multiple horizontal lines for recording additional information.

If more than one screen, show locations of each on sketch.