

Lincoln  
G30  
5-23-72

MISSISSIPPI  
 BOARD OF WATER COMMISSIONERS  
 416 North State Street  
 Jackson, Mississippi 39201

**CODED**

WATER WELL DRILLERS LOG

May 23 1972 Gremm Water Well Contr. Lincoln  
 date well completed firm name county well located

LANDOWNER:	description of formations encountered	from	to
Buddy Sullivan	clay, red sand & gravel	0	120
Route 3, Box 86B			
Brookhaven, Miss.			
(mailing address)			
WELL LOCATION:			
sec. 8 T. 7 N. R. 7 E.			
5 miles W of Brookhaven			
(distance) (direction) (nearest town)			
WELL PURPOSE: home			
(home, irrigation, municipal, industrial)			
WELL COMPLETION DATA:			
(1) diameter (inches) 6"			
(2) total depth (feet) 120			
(3) static water level (feet) 60 below top of ground.			
(4) casing PVC 85' (material) (depth)			
4" (size) if telescope see back.			
(5) screen 6' 85 (length) (depth to top)			
.010 PVC (size) (material)			
(6) pump did not install (HP) (yield gpm)			
(type power)			
(7) electric log no (yes or no)			
(organization running log)			
(8) how well bottom plugged wood			
DRILLERS REMARKS:			


**CODED**

MAY 23 1972

MISSISSIPPI  
 BOARD OF WATER COMMISSIONERS

If well telescopes please sketch and show depths.

GROUND LEVEL

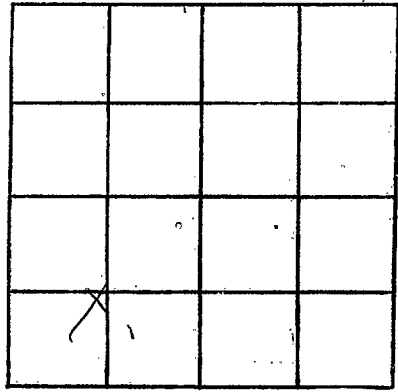

SECTION 8

Please indicate well location X.

ADDITIONAL INFORMATION

A series of horizontal lines for writing additional information, starting below the 'ADDITIONAL INFORMATION' header and extending to the bottom of the page.

If more than one screen, show locations of each on sketch.