

LINCOLN
G31
3-10-72

MISSISSIPPI
 BOARD OF WATER COMMISSIONERS
 416 North State Street
 Jackson, Mississippi 39201

CODED

WATER WELL DRILLERS LOG

March 10 1972 Chester Keener Lincoln
 date well completed firm name county well located

LANDOWNER: Dyerson
Coast Co
Brookhaven, Miss
 (mailing address)

description of formations encountered	from	to
Red Clay	0	21
Red Sand & Shell	21	55
Sand & Gravel	55	74

WELL LOCATION:
 sec. 1 T. 11 N. R. 7 E
1/2 miles NW of Brookhaven
 (distance) (direction) (nearest town)

WELL PURPOSE: Individual
 (home, irrigation, municipal, industrial)

- WELL COMPLETION DATA:
- (1) diameter (inches) 4"
 - (2) total depth (feet) 74
 - (3) static water level (feet) 51 below top of ground.
 - (4) casing Plastic bottom
 (material) (depth)
 - (5) screen 6' 68'
 (length) (depth to top)
 - (6) pump 4" Sub 15
 (HR) (yield gpm)
 - (7) electric log no
 (yes or no)

CODED

(organization running log)

(8) how well bottom plugged New local plug


DRILLERS REMARKS:
New location

JUN 30 1972

MISS. DIV. OF
 WATER RESOURCES

If well telescopes please sketch and show depths.

GROUND LEVEL

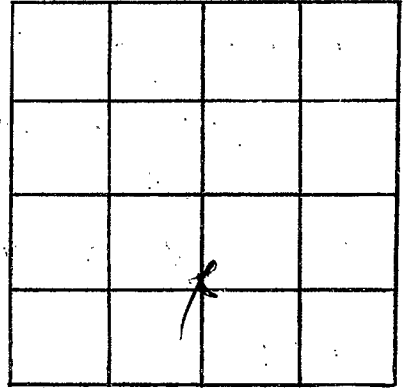

SECTION 1

Please indicate well location X.

ADDITIONAL INFORMATION

If more than one screen, show locations of each on sketch.