

LINCOLN
G 32
7-10-72

MISSISSIPPI
BOARD OF WATER COMMISSIONERS
416 North State Street
Jackson, Mississippi 39201

CODED

WATER WELL DRILLERS LOG

10 July 1972 54 Waterwell Lincoln
date well completed firm name county well located

LANDOWNER:	description of formations encountered	from	to
David W. Sisk & Brook Haven (mailing address)			
WELL LOCATION: sec. 19 T 7 N R 7 E 6 miles W of Brookhaven (distance) (direction) (nearest town)	clay Chalk sand Chalk sand	0 25 50 60 75	25 50 60 75 100
WELL PURPOSE: (home, irrigation, municipal, industrial)			
WELL COMPLETION DATA: (1) diameter (inches) 4 (2) total depth (feet) 100 (3) static water level (feet) 75 below top of ground (4) casing PL 100 (material) (depth) if telescope see back. (5) screen 6 100 (length) (depth to top) H PL (size) (material) (6) pump 1/2 8 (HP) (yield gpm) elect (type power) (7) electric log (yes or no) (organization running log) (8) how well bottom plugged wood			
DRILLERS REMARKS:			


CODED

UGT - 5/19/72

MISS. Bd. of
WATER COMMISSIONERS

If well telescopes please sketch and show depths.

GROUND LEVEL

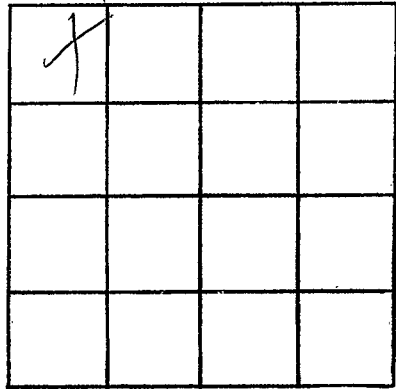

SECTION 19

Please indicate well location X.

ADDITIONAL INFORMATION

If more than one screen,
show locations of each on sketch.