

Lincoln
G 35
11-10-72

MISSISSIPPI
BOARD OF WATER COMMISSIONERS
416 North State Street
Jackson, Mississippi 39201

CODED

WATER WELL DRILLERS LOG


10 Nov 1972 St. Bernard Lincoln
date well completed firm name county well located

LANDOWNER:	description of formations encountered	from	to
D. Wilkins Brookhaven (mailing address)			
WELL LOCATION:			
sec. 24 T 7 N R 7 E 1 miles 75 of Brookhaven (distance) (direction) (nearest town)			
WELL PURPOSE: (home, irrigation, municipal, industrial)			
WELL COMPLETION DATA:			
(1) diameter (inches) 4			
(2) total depth (feet) 200			
(3) static water level (feet) 75 below top of ground.			
(4) casing 11 (material), 188 (depth)			
(size) if telescope see back.			
(5) screen 12 (length), 188 (depth to top)			
4 (size), 11 (material)			
(6) pump 1/2 (HP), 8 (yield gpm)			
split (type power)			
(7) electric log _____			
(yes or no)			
(organization running log)			
(8) how well bottom plugged <u>wood</u>			
DRILLERS REMARKS:			

NOV 10 1972

If well telescopes please sketch and show depths.

GROUND LEVEL

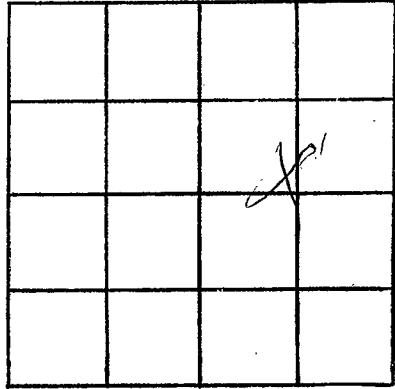

SECTION 24

Please indicate well location X.

ADDITIONAL INFORMATION

If more than one screen,
show locations of each on sketch.