

LINCOLN

G38

2-6-73

MISSISSIPPI BOARD OF WATER COMMISSIONERS 416 North State Street Jackson, Mississippi 39201

CODED

WATER WELL DRILLERS LOG

6 Feb

1973

J. T. Cunningham Lincoln

date well completed

firm name

county well located

LANDOWNER:

Laurie Reed Brookhaven (mailing address)

description of formations encountered

from

to

Clay 0 10
Cherty clay 10 20
Clay 20 40
Sand 40 88
Clay 88 105
Sand 105 128

WELL LOCATION:

sec. 13 T 7 N R 7 E 5 miles west of Brookhaven (distance) (direction) (nearest town)

WELL PURPOSE:

(home, irrigation, municipal, industrial)

WELL COMPLETION DATA:

- (1) diameter (inches) 4
(2) total depth (feet) 128
(3) static water level (feet) 70 below top of ground.
(4) casing 81 (material) 172 (depth)
(5) screen 6 (length) 122 (depth to top)
(6) pump 1/2 (HP) 8 (yield gpm)
(7) electric log (yes or no)

CODED

(organization running log)

(8) how well bottom plugged wood


DRILLERS REMARKS:

Top Sand Concrete...
John...

Stamp: 57 10 1973

If well telescopes please sketch and show depths.

GROUND LEVEL

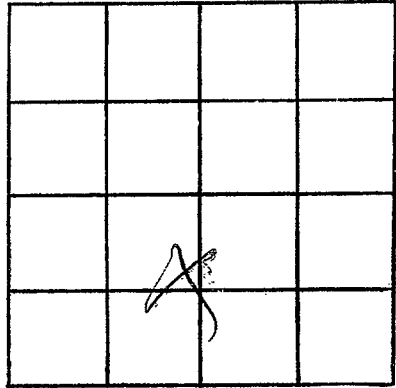

SECTION 18

Please indicate well location X.

ADDITIONAL INFORMATION

If more than one screen,
show locations of each on sketch.