

LINCOLN  
639  
10-4-73

MISSISSIPPI  
BOARD OF WATER COMMISSIONERS  
416 North State Street  
Jackson, Mississippi 39201

CODED

WATER WELL DRILLERS LOG

Oct 4 1973 Grannwater well Cent. Lincoln  
date well completed firm name county well located

LANDOWNER: Rayborn Bowman

description of formations encountered

from to

Brookhaven miss  
(mailing address)

Citronelle

0 80

WELL LOCATION:

sec. 8 T. 7N R. 7E  
4 miles W of Brookhaven  
(distance) (direction) (nearest town)

WELL PURPOSE: Rome  
(home, irrigation, municipal, industrial)

WELL COMPLETION DATA:

- (1) diameter (inches) 6"
- (2) total depth (feet) 60 ft
- (3) static water level (feet) 41 below above top of ground.
- (4) casing PVC, 54,  
(material) (depth)  
4" If telescope see back.  
(size)
- (5) screen 6', 54  
(length) (depth to top)  
1010, PVC  
(size) (material)
- (6) pump did not install  
(HP) (yield gpm)  
  
(type power)
- (7) electric log no  
(yes or no)  
  
(organization running log)
- (8) how well bottom plugged wood


CODED

DRILLERS REMARKS:

OCT 25 1973

If well telescopes please sketch and show depths.

GROUND LEVEL

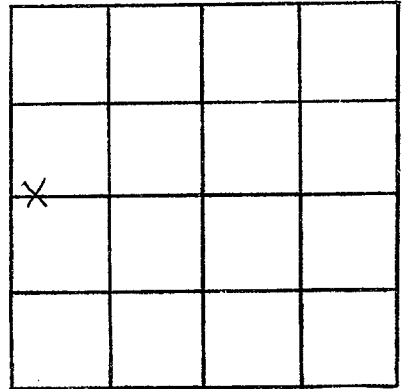

SECTION 8

Please indicate well location X.

ADDITIONAL INFORMATION

If more than one screen,  
show locations of each on sketch.