

LINCOLN
G 40
11-23-73

MISSISSIPPI
BOARD OF WATER COMMISSIONERS
416 North State Street
Jackson, Mississippi 39201 CODED

WATER WELL DRILLERS LOG

23 Nov 1973 J.T. Conroy & Son Local
date well completed firm name county well located

LANDOWNER: For Perkins Road
Mr. Bowman Folsom Road
Brookhaven Ala
(mailing address)

description of formations encountered	from	to
Clay	0	25
Chalk	25	63
Sand	55	75
Chert	75	130
Ford	730	754

WELL LOCATION:
sec. 5 T 7 N R 7 E
S W
5 miles west of Brookhaven
(distance) (direction) (nearest town)

WELL PURPOSE:
(home, irrigation, municipal, industrial)

WELL COMPLETION DATA:

(1) diameter (inches) 4

(2) total depth (feet) 254

(3) static water level (feet) 90 below top of ground.

(4) casing PL 242 (material) (depth)
if telescope see back.
(size)

(5) screen 12 242 (length) (depth to top)
1/2 PL (size) (material)

(6) pump (HP) (yield gpm)

(7) electric log Custom Potam pump (yes or no)
(organization running log)


(8) how well bottom plugged wood

CODED

DRILLERS REMARKS:
Salt water well at 70 ft.
we put a pack below 1st formation
& from cement on top of pack

If well telescopes please sketch and show depths.

GROUND LEVEL

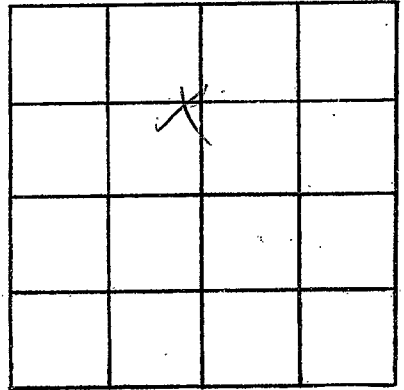

SECTION 5

Please indicate well location X.

ADDITIONAL INFORMATION

If more than one screen, show locations of each on sketch.