

LINCOLN
G 41
3-1-74

MISSISSIPPI
BOARD OF WATER COMMISSIONERS
416 North State Street
Jackson, Mississippi 39201

CODED

WATER WELL DRILLERS LOG

1 March 1974 H. Conzation Lincoln
date well completed firm name county well located

LANDOWNER:
Bill Ray Reed
Brakham Miss.
(mailing address)

description of formations encountered	from	to
Clay	0	70
Clay	20	50
Shale	50	75
Chalk	75	90
Sand	90	128

WELL LOCATION:
sec. 8 T 7 N R 7 E
5 miles W of Brakham
(distance) (direction) (nearest town)

WELL PURPOSE:
(home irrigation, municipal, industrial)

WELL COMPLETION DATA:

(1) diameter (inches) 4

(2) total depth (feet) 128

(3) static water level (feet) 70 below above top of ground.

(4) casing PI, 122,
(material) (depth)
(size) if telescope see back.

(5) screen 6, 122
(length) (depth to top)
4, PI
(size) (material)

(6) pump 1/2, 0
(HP) (yield gpm)
elect
(type power)

(7) electric log _____
(yes or no)
(organization running log)

(8) how well bottom plugged wood

CODED


DRILLERS REMARKS:
Concent top sand
off from bottom
Be careful of Salt

APR 1 1974

If well telescopes please
sketch and show depths.

GROUND LEVEL

(Faint sketch of a vertical line with a small horizontal tick mark at the top and some scribbles below)

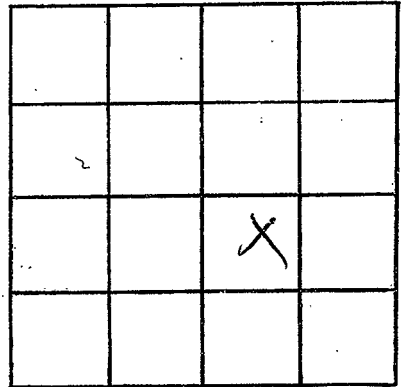

SECTION 8

Please indicate well location X.

ADDITIONAL INFORMATION

(A series of 18 horizontal lines for text entry.)

If more than one screen,
show locations of each on sketch.