

LINCOLN
G 42
2-18-74

MISSISSIPPI
BOARD OF WATER COMMISSIONERS
416 North State Street
Jackson, Mississippi 39201

CODED

WATER WELL DRILLERS LOG

Feb. 18 1974 Grenn W.W. Co. Inc. Lincoln
date well completed firm name county well located

LANDOWNER: Ernest H. Allen
Route 3 Box 78
Brookhaven Miss.
(mailing address)

description of formations encountered	from	to
<u>Citronelle</u>	<u>0</u>	<u>95</u>

WELL LOCATION:
sec. 5 T 7 N R 7 E
7 miles NW of Brookhaven
(distance) (direction) (nearest town)

WELL PURPOSE: home
(home, irrigation, municipal, industrial)

- WELL COMPLETION DATA:
- (1) diameter (inches) 6"
 - (2) total depth (feet) 95'
 - (3) static water level (feet) 65' below above top of ground.
 - (4) casing PVC, 89',
(material) (depth)
4" if telescope see back.
(size)
 - (5) screen 6", 89'
(length) (depth to top)
1.010, PVC
(size) (material)
 - (6) pump 1/3 sub, 7
(HP) (yield gpm)
electric
(type power)
 - (7) electric log no
(yes or no)
(organization running log)
 - (8) how well bottom plugged Wood

CODED




APR 31 1974

DRILLERS REMARKS: _____
MISS. BD. OF WATER COMMISSIONERS

If well telescopes please sketch and show depths.

GROUND LEVEL

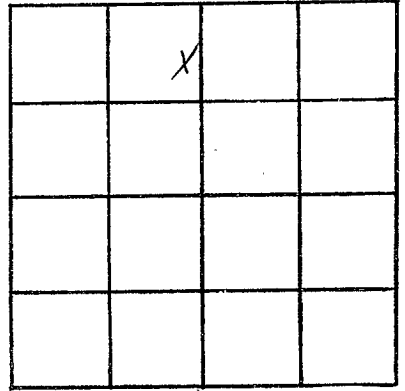

SECTION 5

Please indicate well location X.

ADDITIONAL INFORMATION

If more than one screen,
show locations of each on sketch.