

LINCOLN  
 644  
 5-27-74

MISSISSIPPI  
 BOARD OF WATER COMMISSIONERS CODED  
 416 North State Street  
 Jackson, Mississippi 39201  
 WATER WELL DRILLERS LOG

May 28 27 19 74 Green Water Well Cont Lincoln  
 date well completed firm name county well located

LANDOWNER: New Prospect Church  
 Rt. 5, Box 266X, Brookhaven (mailing address)  
 description of formations encountered Citronelle  
 from 0 to 118

WELL LOCATION: CODED  
 sec 32 T 7 N R 7 E  
 5 miles W of Brookhaven  
 (distance) (direction) (nearest town)

WELL PURPOSE: Church  
 (home, irrigation, municipal, industrial)

- WELL COMPLETION DATA:
- (1) diameter (inches) 6"
  - (2) total depth (feet) 118
  - (3) static water level (feet) 45 below above top of ground.
  - (4) casing PVC, 112 (material) (depth)  
 4" (size) If telescope see back.
  - (5) screen 6" 112 (length) (depth to top)  
 .010 PVC (size) (material)
  - (6) pump 1/2 sub 7 (HP) (yield gpm)  
 electric (type power)
  - (7) electric log no (yes or no)
  - (8) how well bottom plugged wood

DRILLERS REMARKS:


RECEIVED  
 MISSISSIPPI  
 MAY 27 1974

MISS. BD. OF WATER COMM.

①

If well telescopes please sketch and show depths.

GROUND LEVEL

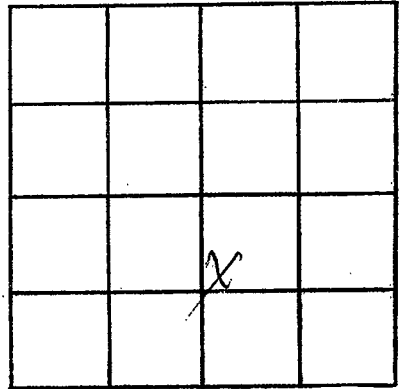

SECTION 32

Please indicate well location X.

ADDITIONAL INFORMATION

If more than one screen, show locations of each on sketch.