

LINCOLN

G 45

8-19-74

MISSISSIPPI BOARD OF WATER COMMISSIONERS

416 North State Street

Jackson, Mississippi 39201

CODED

WATER WELL DRILLERS LOG

8-19

date well completed

1974

firm name

F. H. G. & S. Co.

Lincoln

county well located

LANDOWNER:

Dr. Strong

R.R. - Beulah
(mailing address)

description of formations encountered

from

to

Red clay

0 20

Red soil

20 63

white chalk

63 75

fine sand

75 108

loam sand & gravel

108 117

WELL LOCATION:

sec. 11 T. 7 N. R. 7 E

2 miles W of Beulah
(distance) (direction) (nearest town)

WELL PURPOSE:

(home, irrigation, municipal, industrial)

CODED

WELL COMPLETION DATA:

- (1) diameter (inches) 4
- (2) total depth (feet) 117
- (3) static water level (feet) 55 below top of ground.
- (4) casing (material) plastic, (depth) 109, (size) 4 if telescope see back.
- (5) screen (length) 8, (depth to top) 109, (size) 4, (material) plastic
- (6) pump (HP) 1/2, (yield gpm) 10, (type power) elec
- (7) electric log (yes or no) no
- (organization running log)
- (8) how well bottom plugged sand


DRILLERS REMARKS:

RECEIVED
AUG 26 1974

MISS. Bd. OF WA

If well telescopes please sketch and show depths.

GROUND LEVEL

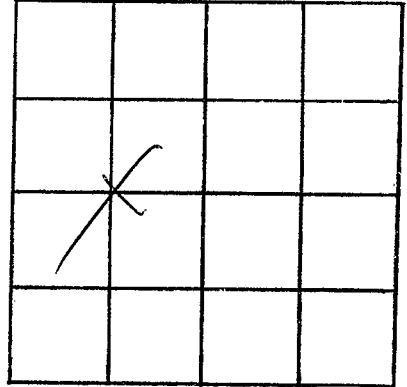

SECTION 11

Please indicate well location X.

ADDITIONAL INFORMATION

If more than one screen, show locations of each on sketch.