

LINCOLN
646
4-23-75

MISSISSIPPI
BOARD OF WATER COMMISSIONERS
416 North State Street
Jackson, Mississippi 39201

CODED

WATER WELL DRILLERS LOG

April 23 19 75 Grem Water Well Cont. Lincoln
date well completed firm name county well located

LANDOWNER:	description of formations encountered	from	to
Kenneth F. Magee			
Route 5 Brookhaven, Mkss. (mailing address)			
WELL LOCATION:			
sec. <u>32</u> T <u>7</u> N R <u>7</u> E = <u>S</u> = <u>W</u> =			
<u>5</u> miles SW of Brookhaven (distance) (direction) (nearest town)			
WELL PURPOSE: <u>home</u> (home, irrigation, municipal, industrial)			
WELL COMPLETION DATA:			
(1) diameter (inches) <u>6"</u>			
(2) total depth (feet) <u>95</u>			
(3) static water level (feet) <u>66</u> <u>below</u> <u>above</u> top of ground.			
(4) casing <u>PVC</u> <u>89'</u> (material) (depth) <u>4"</u> if telescope see back. (size)			
(5) screen <u>6'</u> <u>89'</u> (length) (depth to top) <u>.010</u> <u>PVC</u> (size) (material)			
(6) pump <u>did not install</u> (HP) (yield gpm)			
(type power)			
(7) electric log <u>no</u> (yes or no)			
(organization running log)			
(8) how well bottom plugged <u>wood</u>			


RECEIVED

MAY - 9 1975

DRILLERS REMARKS:

If well telescopes please sketch and show depths.

GROUND LEVEL

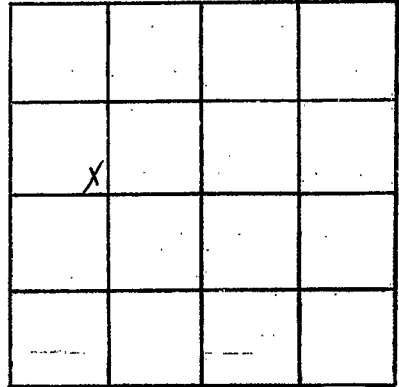

SECTION 32

Please indicate well location X.

ADDITIONAL INFORMATION

If more than one screen, show locations of each on sketch.