

CODED

MISSISSIPPI
BOARD OF WATER COMMISSIONERS
416 North State Street
Jackson, Mississippi 39201

WATER WELL DRILLERS LOG

Lincoln
G 47
6-5-75

June 5 1975
date well completed

Green Water Well
firm name

Lincoln
county well located


LANDOWNER:	description of formations encountered	from	to
Cameron Smith 245 Rogers Circle Brookhaven, Miss. (mailing address)			
WELL LOCATION:			
sec. <u>22</u> T <u>7</u> <u>N</u> R <u>7</u> <u>E</u> 13 <u>2</u> S			
<u>2</u> miles <u>W</u> of <u>Brookhaven</u> (distance) (direction) (nearest town)			
WELL PURPOSE: <u>home</u> (home, irrigation, municipal, industrial)			
WELL COMPLETION DATA:			
(1) diameter (inches) <u>6"</u>			
(2) total depth (feet) <u>70</u>			
(3) static water level (feet) <u>50</u> below/above top of ground.			
(4) casing <u>PVC</u> <u>64</u> (material) (depth) <u>4"</u> (size) if telescope see back.			
(5) screen <u>6'</u> <u>64'</u> (length) (depth to top) <u>.010</u> <u>PVC</u> (size) (material)			
(6) pump <u>did not install</u> (HP) (yield gpm)			
(type power)			
(7) electric log <u>no</u> (yes or no)			
(organization running log)			
(8) how well bottom plugged <u>wood</u>			
DRILLERS REMARKS:			

RECORDED
INDEXED
SEP 18 1975

MISS. Bd. OF WATER COMMISSIONERS

If well telescopes please sketch and show depths.

GROUND LEVEL

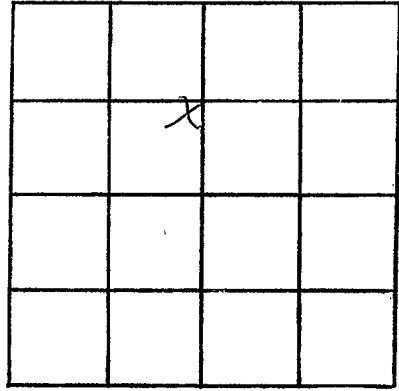

SECTION 22

Please indicate well location X.

ADDITIONAL INFORMATION

If more than one screen,
show locations of each on sketch.