

CODED


MISSISSIPPI  
BOARD OF WATER COMMISSIONERS  
416 North State Street  
Jackson, Mississippi 39201

WATER WELL DRILLERS LOG

Lincoln  
G 50  
7-24-75

July 24 1975 Grenn Water Well Cont. Lincoln  
date well completed firm name county well located

LANDOWNER:	description of formations encountered	from	to
Hayles Animal Clinic Brookhaven, Miss. (mailing address)			
<b>WELL LOCATION:</b>			
sec. <u>14</u> T <u>7</u> N R <u>7</u> E 13X <u>5</u> S <u>W</u>			
<u>1</u> miles <u>W</u> of <u>Brookhaven</u> (distance) (direction) (nearest town)			
<b>WELL PURPOSE:</b> <u>Animal Clinic</u> (home, irrigation, municipal, industrial)			
<b>WELL COMPLETION DATA:</b>			
(1) diameter (inches) <u>6"</u>			
(2) total depth (feet) <u>156</u>			
(3) static water level (feet) <u>55</u> below top of ground. above			
(4) casing <u>PVC</u> <u>150</u> (material) (depth) <u>4"</u> (size) if telescope see back.			
(5) screen <u>6</u> <u>150</u> (length) (depth to top) <u>.010</u> <u>PVC</u> (size) (material)			
(6) pump <u>did not install</u> (HP) (yield gpm)  (type power)			
(7) electric log <u>no</u> (yes or no)  (organization running log)			
(8) how well bottom plugged <u>wood</u>			
<b>DRILLERS REMARKS:</b>			

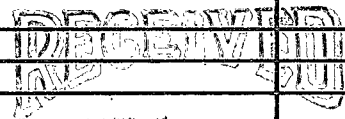

SEP 18 1975

MISS. Bd. of Water Comm.

