

CODED

Lincoln
G 51
7-16-75

MISSISSIPPI
BOARD OF WATER COMMISSIONERS
416 North State Street
Jackson, Mississippi 39201

WATER WELL DRILLERS LOG

July 16 1975 Grenn Water Well Cont. Lincoln

date well completed firm name county well located


LANDOWNER:	description of fomations encountered	from	to
Norris Norton 216 Rogers Circle Brookhaven, Miss. (mailing address)	Citronell $\text{\textcircled{S}}$	0	120
WELL LOCATION: sec <u>9</u> T <u>7</u> $\text{\textcircled{N}}$ R <u>7</u> $\text{\textcircled{E}}$ <u>2</u> miles <u>W</u> of <u>Brookhaven</u> (distance) (direction) (nearest town)			
WELL PURPOSE: home (home, irrigation, municipal, industrial)			
WELL COMPLETION DATA:			
(1) diameter (inches) <u>6"</u>			
(2) total depth (feet) <u>120</u>			
(3) static water level (feet) <u>20</u> below top of ground. above			
(4) casing <u>PVC</u> <u>114</u> (material) (depth) <u>4 1/2"</u> If telescope see back. (size)			
(5) screen <u>6</u> <u>114</u> (length) (depth to top) <u>.010</u> <u>PVC</u> (size) (material)			
(6) pump <u>did not install</u> (HP) (yield gpm) (type power)			
(7) electric log <u>no</u> (yes or no) (organization running log)			
(8) how well bottom plugged <u>wood</u>			
DRILLERS REMARKS:			

RECORDED
INDEXED
SEP 28 1975

MISS. BD. OF WATER COMMISSIONERS

If well telescopes please sketch and show depths.

GROUND LEVEL

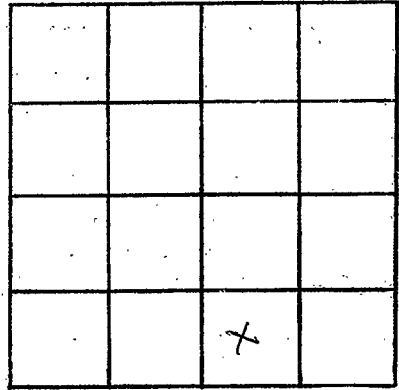

SECTION 9

Please indicate well location X.

ADDITIONAL INFORMATION

If more than one screen, show locations of each on sketch.