

LINCOLN
570
6-4-82

MISSISSIPPI DEPARTMENT OF NATURAL RESOURCES
 Bureau of Land and Water Resources
 Southport Mall
 P.O. Box 10631
 Jackson, Mississippi 39209
WATER WELL DRILLERS LOG

288C

June 4 1982 Grenn Water Well Lincoln
 date well completed firm name county well located


LANDOWNER: Ogden Oil Co.
 P.O. Box 564
 Natchez, Ms.
 (mailing address)

description of formations encountered	from	to
clay	1	15
sand & gravel	15	35
white clay	35	75
sand	75	156

WELL LOCATION:
 sec 26 T 7 N R 7 E
 1 miles South of Brookhaven
 (distance) (direction) (nearest town)

WELL PURPOSE: industrial
 (home, irrigation, municipal, industrial)

WELL COMPLETION DATA:
 (1) diameter (inches) 4
 (2) total depth (feet) 156
 (3) static water level (feet) 33 (below/above top of ground)
 (4) casing PVC 136 (material), (depth)
 4" (size) if telescope see back.
 (5) screen 20" (length), 136" (depth to top)
 .010 PVC (size) (material)
 (6) pump 5 sub 50 (HP) (yield gpm)
 electricity (type power)
 (7) electric log no (yes or no)
 (organization running log)
 (8) how well bottom plugged back wash valve

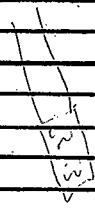
Elevation: 400 feet
 09028243230


DRILLERS REMARKS:

DEPT. OF NATURAL RESOURCES
 BUREAU OF LAND & WATER RESOURCES
 JUL -1 1982
RECEIVED

If well telescopes please sketch and show depths.

GROUND LEVEL

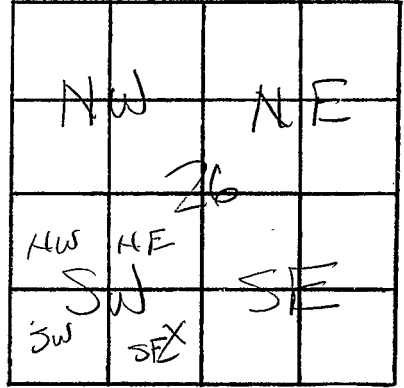

SECTION 26

Please indicate well location X.

ADDITIONAL INFORMATION

If more than one screen,
show locations of each on sketch.