

Lincoln
G-74

MISSISSIPPI DEPARTMENT OF NATURAL RESOURCES
Bureau of Land and Water Resources
Southport Mall
P.O. Box 10631
Jackson, Mississippi 39209
WATER WELL DRILLERS LOG

CODED

May 4 1982 Grenn Water Well Lincoln
date well completed firm name county well located

LANDOWNER:	description of fomations encountered	from	to
Jack Hostetler	clay	1	10
514 W. Chippewa St.	sand & gravel	10	22
Brookhaven, Ms.	white clay	22	30
(mailing address)	blue clay	30	90
	sand	90	120

WELL LOCATION:
sec. 21 T. 7 N. R. 7 E
S W
2 miles West of Brookhaven
(distance) (direction) (nearest town)

WELL PURPOSE: home
(home, irrigation, municipal, industrial)

WELL COMPLETION DATA:

- (1) diameter (inches) 4
- (2) total depth (feet) 120
- (3) static water level (feet) 10 below above top of ground.
- (4) casing PVC 110
(material) (depth)
4" if telescope see back.
(size)
- (5) screen 10' 110'
(length) (depth to top)
.010 PVC
(size) (material)
- (6) pump did not install
(HP) (yield gpm)

(type power)
- (7) electric log no
(yes or no)

(organization running log)
- (8) how well bottom plugged Back Wash Valve

CODED

DEPT. OF NATURAL RESOURCES
BUREAU OF LAND & WATER RESOURCES


JUL 1 1982

RECEIVED

DRILLERS REMARKS:

If well telescopes please sketch and show depths.

GROUND LEVEL

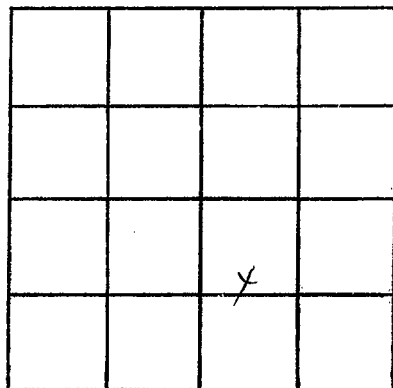

SECTION 21

Please indicate well location X.

ADDITIONAL INFORMATION

If more than one screen,
show locations of each on sketch.